


1 LOCATION OF WATER WELL: County: Coffey Fraction: NE 1/4 NE 1/4 NE 1/4 Section Number: 23 Township Number: T 19 S Range Number: R 16 EW

Distance and direction from nearest town or city street address of well if located within city?
1st & Pierson, Waverly, Ks.

2 WATER WELL OWNER: Dave Lybarger/Lybarger Oil
RR#, St. Address, Box #: P.O. Box 99 Board of Agriculture, Division of Water Resources
City, State, ZIP Code: Garnett, Ks. 66032 Application Number:

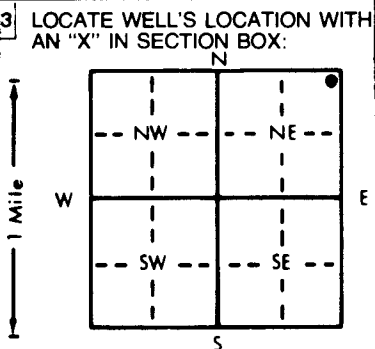

4 DEPTH OF COMPLETED WELL: 14'6" ft. ELEVATION: ft.
Depth(s) Groundwater Encountered: 1. 7' ft. 2. ft. 3. ft.
WELL'S STATIC WATER LEVEL: 6.78 ft. below land surface measured on mo/day/yr 6-20-96
Pump test data: Well water was ft. after hours pumping gpm
Est. Yield gpm; Well water was ft. after hours pumping gpm
Bore Hole Diameter: 3 1/2" in. to 7" ft., and 5 1/2" in. to 14'6" ft.
WELL WATER TO BE USED AS: 5 Public water supply 8 Air conditioning 11 Injection well
1 Domestic 3 Feedlot 6 Oil field water supply 9 Dewatering 12 Other (Specify below)
2 Irrigation 4 Industrial 7 Lawn and garden only 10 Monitoring well Observation Well
Was a chemical/bacteriological sample submitted to Department? Yes.....No X.....; If yes, mo/day/yr sample was submitted
Water Well Disinfected? Yes No

5 TYPE OF BLANK CASING USED: 1 Steel 3 RMP (SR) 5 Wrought iron 8 Concrete tile CASING JOINTS: Glued Clamped
2 PVC 4 ABS 6 Asbestos-Cement 9 Other (specify below) Welded
Blank casing diameter: 2.375 in. to 7' ft., Dia. in. to sdr 13 ft.
Casing height above land surface: Flush Mt. in., weight lbs./ft. Wall thickness or gauge No. sch 40
TYPE OF SCREEN OR PERFORATION MATERIAL: 7 PVC 10 Asbestos-cement
1 Steel 3 Stainless steel 5 Fiberglass 8 RMP (SR) 11 Other (specify)
2 Brass 4 Galvanized steel 6 Concrete tile 9 ABS 12 None used (open hole)
SCREEN OR PERFORATION OPENINGS ARE: 5 Gauzed wrapped 8 Saw cut 11 None (open hole)
1 Continuous slot 3 Mill slot 6 Wire wrapped 9 Drilled holes
2 Louvered shutter 4 Key punched 7 Torch cut 10 Other (specify)
SCREEN-PERFORATED INTERVALS: From 14'6" ft. to 7' ft., From ft. to ft.
GRAVEL PACK INTERVALS: From 14'6" ft. to 6' ft., From ft. to ft.

6 GROUT MATERIAL: 1 Neat cement 2 Cement grout 3 Bentonite 4 Other
Grout Intervals: From 6' ft. to 4' ft., From 4' ft. to 0' ft., From ft. to ft.
What is the nearest source of possible contamination: 10 Livestock pens 14 Abandoned water well
1 Septic tank 4 Lateral lines 7 Pit privy 11 Fuel storage 15 Oil well/Gas well
2 Sewer lines 5 Cess pool 8 Sewage lagoon 12 Fertilizer storage 16 Other (specify below)
3 Watertight sewer lines 6 Seepage pit 9 Feedyard 13 Insecticide storage

Direction from well? East How many feet? 55'

FROM	TO	LITHOLOGIC LOG	FROM	TO	PLUGGING INTERVALS
0	1	Gravel			
1	4	Blk silty clay w/ trace amt. ls.rx. gravel, dry-moist, firm, mod. odor,, low plasticity.			
4	6	Red brn silty clay w/ dk gray clay mottling, moist, strong odor, firm, low plasticity.			
6	9.25	Weathered limestone to hard consolidated limestone, fractured, thinly bedded, shale partings, dry.			
9.25	14'6"	Gray crystalline limestone, hard, dry.			
F.M.OK'd by Don Taylor					

7 CONTRACTOR'S OR LANDOWNER'S CERTIFICATION: This water well was (1) constructed (2) reconstructed, or (3) plugged under my jurisdiction and was completed on (mo/day/year) 6-19-96 and this record is true to the best of my knowledge and belief. Kansas Water Well Contractor's License No. 539 This Water Well Record was completed on (mo/day/yr) 6-26-96 under the business name of JB Environmental Drilling by (signature) James Baker

INSTRUCTIONS: Use typewriter or ball point pen. PLEASE PRESS FIRMLY and PRINT clearly. Please fill in blanks, underline or circle the correct answers. Send top three copies to Kansas Department of Health and Environment, Bureau of Water, Topeka, Kansas 66620-0001. Telephone: 913-296-5545. Send one to WATER WELL OWNER and retain one for your records.

OFFICE USE ONLY
T
R
EW
SEC