


1 LOCATION OF WATER WELL: County: Coffey Fraction: NE 1/4 NE 1/4 NE 1/4 Section Number: 23 Township Number: T 19 S Range Number: R 16 E

Distance and direction from nearest town or city street address of well if located within city?
1st & Pierson, Waverly, Ks.

2 WATER WELL OWNER: Dave Lybarger/Lybarger Oil
 RR#, St. Address, Box #: P.O. Box 99 Board of Agriculture, Division of Water Resources
 City, State, ZIP Code: Garnett, Ks. 66032 Application Number:

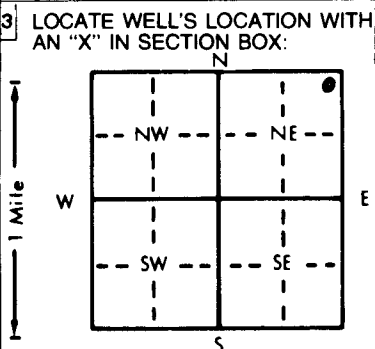

4 DEPTH OF COMPLETED WELL: 13' ft. ELEVATION: ft.
 Depth(s) Groundwater Encountered: 1. 7' ft. 2. ft. 3. ft.
 WELL'S STATIC WATER LEVEL: 6.20 ft. below land surface measured on mo/day/yr 6-20-96
 Pump test data: Well water was ft. after hours pumping gpm
 Est. Yield gpm: Well water was ft. after hours pumping gpm
 Bore Hole Diameter: 8 1/2" in. to 7' ft., and 5 1/2" in. to 13' ft.
 WELL WATER TO BE USED AS:
 5 Public water supply 8 Air conditioning 11 Injection well
 1 Domestic 3 Feedlot 6 Oil field water supply 9 Dewatering 12 Other (Specify below)
 2 Irrigation 4 Industrial 7 Lawn and garden only 10 Monitoring well Observation well
 Was a chemical/bacteriological sample submitted to Department? Yes..... No. X.....; If yes, mo/day/yr sample was submitted
 Water Well Disinfected? Yes No. (No)

5 TYPE OF BLANK CASING USED:
 1 Steel 3 RMP (SR) 5 Wrought iron 8 Concrete tile CASING JOINTS: Glued Clamped
2 PVC 4 ABS 6 Asbestos-Cement 9 Other (specify below) Welded
 7 Fiberglass Threaded. X
 Blank casing diameter 2.375 in. to 7' ft., Dia in. to ft., Dia in. to sdr 13 ft.
 Casing height above land surface: Flush Mt. in., weight lbs./ft. Wall thickness or gauge No. sch 40
 TYPE OF SCREEN OR PERFORATION MATERIAL:
 1 Steel 3 Stainless steel 5 Fiberglass 8 RMP (SR) 10 Asbestos-cement 11 Other (specify)
 2 Brass 4 Galvanized steel 6 Concrete tile 9 ABS 12 None used (open hole)
 SCREEN OR PERFORATION OPENINGS ARE:
 1 Continuous slot 3 Mill slot 5 Gauzed wrapped 8 Saw cut 11 None (open hole)
 2 Louvered shutter 4 Key punched 6 Wire wrapped 9 Drilled holes
 7 Torch cut 10 Other (specify)
 SCREEN-PERFORATED INTERVALS: From 13' ft. to 7' ft., From ft. to ft.
 From ft. to ft., From ft. to ft.
 GRAVEL PACK INTERVALS: From 13' ft. to 6' ft., From ft. to ft.
 From ft. to ft., From ft. to ft.

6 GROUT MATERIAL: 1 Neat cement 2 Cement grout 3 Bentonite 4 Other
 Grout Intervals: From 6' ft. to 4' ft., From 4' ft. to 0' ft., From ft. to ft.
 What is the nearest source of possible contamination:
 1 Septic tank 4 Lateral lines 7 Pit privy 10 Livestock pens 14 Abandoned water well
 2 Sewer lines 5 Cess pool 8 Sewage lagoon 11 Fuel storage above 15 Oil well/Gas well
 3 Watertight sewer lines 6 Seepage pit 9 Feedyard 12 Fertilizer storage above 16 Other (specify below)
 13 Insecticide storage
 Direction from well? South How many feet? 10'

FROM	TO	LITHOLOGIC LOG	FROM	TO	PLUGGING INTERVALS
0	1	Ls Rx. gravel road base.			
1	4	Dk gray-blk silty clay w/ few ls.rx. gravel pebbles, moist, strong odor, low-med plasticity.			
4	6	Red brn clay w/ gray clay mottling, moist, strong odor.			
6	9.50	Weathered limestone w/ gray shale partings, wet at 7', strong odor.			
9.50	13	Limestone-interbedded-3"-8" thick, gray dense, crystalline.			
					F.M.OK'd by Don Taylor

7 CONTRACTOR'S OR LANDOWNER'S CERTIFICATION: This water well was (1) constructed (2) reconstructed, or (3) plugged under my jurisdiction and was completed on (mo/day/year) 6-20-96 and this record is true to the best of my knowledge and belief. Kansas Water Well Contractor's License No. 539 This Water Well Record was completed on (mo/day/yr) 6-20-96 under the business name of JB Environmental Drilling by (signature) James Baker

OFFICE USE ONLY
T
R
EW
SEC
1/4
1/4
1/4