


**WATER WELL RECORD Form WWC-5 KSA 82a-1212**

|   |   |                             |                                  |                                |
|---|---|-----------------------------|----------------------------------|--------------------------------|
| <b>1 LOCATION OF WATER WELL:</b><br>County: <u>COFFEY</u> | Fraction<br><u>NW 1/4 NW 1/4 NW 1/4</u> | Section Number<br><u>29</u> | Township Number<br><u>T 19 S</u> | Range Number<br><u>R 16 EW</u> |
|---|---|-----------------------------|----------------------------------|--------------------------------|

Distance and direction from nearest town or city street address of well if located within city?

1 mile south, 3 3/4 west of Waverly

|   |  |
|---|--|
| <b>2 WATER WELL OWNER:</b> <u>Donnie Sidebottom</u><br>RR#, St. Address, Box # : <u>613 Senior Street</u><br>City, State, ZIP Code : <u>Waverly, KS 66871</u> | Board of Agriculture, Division of Water Resources<br>Application Number: |
|---|--|

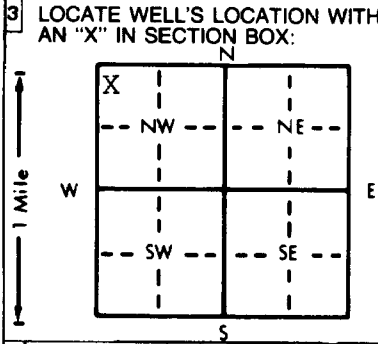

|   |  |                          |
|---|--|--------------------------|
| <b>4 DEPTH OF COMPLETED WELL:</b> <u>140'</u> ft. ELEVATION: .....  | <b>DEPTH OF COMPLETED WELL:</b> 1. <u>120'</u> ft. 2. .... ft. 3. .... ft. |                          |
| <b>WELL'S STATIC WATER LEVEL:</b> <u>73'</u> ft. below land surface measured on <u>mo/day/yr</u> <u>11/30/99</u>                  |  |                          |
| Pump test data: Well water was ..... ft. after ..... hours pumping ..... gpm  |  |                          |
| Est. Yield <u>40 GPH</u> : Well water was ..... ft. after ..... hours pumping ..... gpm   |  |                          |
| Bore Hole Diameter: <u>8 3/4</u> in. to ..... ft., and ..... in. to ..... ft.   |  |                          |
| <b>WELL WATER TO BE USED AS:</b>  |  |                          |
| 5 Public water supply   | 8 Air conditioning   | 11 Injection well        |
| 1. <u>Domestic</u>  | 3 Feedlot  | 6 Oil field water supply |
| 2 Irrigation  | 4 Industrial   | 7 Lawn and garden only   |
| 10 Monitoring well  |  |                          |
| 12 Other (Specify below)  |  |                          |
| Was a chemical/bacteriological sample submitted to Department? Yes.....No.. <u>X</u> ..... If yes, mo/day/yr sample was submitted |  |                          |
| Water Well Disinfected? Yes <u>X</u> No   |  |                          |

|   |                    |                   |   |
|---|--------------------|-------------------|---|
| <b>5 TYPE OF BLANK CASING USED:</b>   | 5 Wrought iron     | 8 Concrete tile   | CASING JOINTS: Glued .. <u>X</u> .. Clamped ..... |
| 1 Steel   | 3 RMP (SR)         | 6 Asbestos-Cement | 9 Other (specify below)                           |
| <u>2 PVC</u>  | 4 ABS              | 7 Fiberglass      | Welded .....                                      |
| Blank casing diameter ..... 5" ..... in. to <u>0-80</u> ..... ft., Dia ..... 5" ..... in. to <u>130-140</u> ..... ft., Dia ..... in. to ..... ft. |                    |                   |   |
| Casing height above land surface ..... 24" ..... in., weight ..... 2.82 ..... lbs./ft. Wall thickness or gauge No. .... 258                       |                    |                   |   |
| <b>TYPE OF SCREEN OR PERFORATION MATERIAL:</b>  |                    |                   |   |
| 1 Steel   | 3 Stainless steel  | 5 Fiberglass      | <u>7 PVC</u>                                      |
| 2 Brass   | 4 Galvanized steel | 6 Concrete tile   | 8 RMP (SR)  |
| SCREEN OR PERFORATION OPENINGS ARE:   |                    |                   |   |
| 1 Continuous slot   | 3 Mill slot        | 5 Gauzed wrapped  | <u>8 Saw cut</u>                                  |
| 2 Louvered shutter  | 4 Key punched      | 6 Wire wrapped    | 9 Drilled holes                                   |
| SCREEN-PERFORATED INTERVALS: From ..... 80 ..... ft. to ..... 130 ..... ft., From ..... ft. to ..... ft.  |                    |                   |   |
| GRAVEL PACK INTERVALS: From ..... 24 ..... ft. to ..... 140 ..... ft., From ..... ft. to ..... ft.  |                    |                   |   |
| 11 None used (open hole)  |                    |                   |   |

|   |                 |                 |                       |                          |
|---|-----------------|-----------------|-----------------------|--------------------------|
| <b>6 GROUT MATERIAL:</b>  | 1 Neat cement   | 2 Cement grout  | <u>3 Bentonite</u>    | 4 Other .....            |
| Grout intervals: From ..... 4 ..... ft. to ..... 24 ..... ft., From ..... ft. to ..... ft., From ..... ft. to ..... ft. |                 |                 |                       |                          |
| What is the nearest source of possible contamination:   |                 |                 |                       |                          |
| <u>1 Septic tank</u>  | 4 Lateral lines | 7 Pit privy     | 10 Livestock pens     | 14 Abandoned water well  |
| 2 Sewer lines   | 5 Cess pool     | 8 Sewage lagoon | 11 Fuel storage       | 15 Oil well/Gas well     |
| 3 Watertight sewer lines  | 6 Seepage pit   | 9 Feedyard      | 12 Fertilizer storage | 16 Other (specify below) |
| Direction from well? <u>SOUTH</u> How many feet? <u>160'</u>  |                 |                 |                       |                          |

| FROM | TO | LITHOLOGIC LOG | FROM | TO  | PLUGGING INTERVALS |
|------|----|----------------|------|-----|--------------------|
| 0    | 3  | Top Soil       | 79   | 80  | Shale-Grey         |
| 3    | 9  | Clay-Brown     | 80   | 82  | Limestone-Grey     |
| 9    | 12 | Limestone-Grey | 82   | 114 | Shale-Grey         |
| 12   | 17 | Shale-Grey     | 114  | 118 | Sandy Shale-Grey   |
| 17   | 19 | Limestone-Grey | 118  | 126 | Sandstone-Grey     |
| 19   | 21 | Shale-Grey     | 126  | 128 | Shale-Grey         |
| 21   | 23 | Limestone-Grey | 128  | 140 | Limestone-Grey     |
| 23   | 35 | Shale-Grey     |      |     |                    |
| 35   | 41 | Limestone-Grey |      |     |                    |
| 41   | 42 | Shale-Grey     |      |     |                    |
| 42   | 43 | Limestone-Grey |      |     |                    |
| 43   | 50 | Shale-Grey     |      |     |                    |
| 50   | 51 | Limestone-Grey |      |     |                    |
| 51   | 77 | Shale-Grey     |      |     |                    |
| 77   | 79 | Limestone-Grey |      |     |                    |

|  |
|--|
| <b>7 CONTRACTOR'S OR LANDOWNER'S CERTIFICATION:</b> This water well was (1) constructed, (2) reconstructed, or (3) plugged under my jurisdiction and was completed on (mo/day/year) <u>11/30/99</u> and this record is true to the best of my knowledge and belief. Kansas Water Well Contractor's License No. <u>182</u> This Water Well Record was completed on (mo/day/yr) <u>12-10-99</u> under the business name of <u>STRADER DRILLING CO., INC.</u> by (signature) <u>Dale Ashton</u> |
|--|

INSTRUCTIONS: Use typewriter or ball point pen. PLEASE PRESS FIRMLY and PRINT clearly. Please fill in blanks, underline or circle the correct answers. Send top three copies to Kansas Department of Health and Environment, Bureau of Water, Topeka, Kansas 66620-0001. Telephone: 913-296-5545. Send one to WATER WELL OWNER and retain one for your records.

OFFICE USE ONLY  
T  
R  
EW  
SEC.  
1/4  
1/4  
1/4