

CORRECTION(S) TO WATER WELL RECORD (WWC-5)

(to rectify lacking or incorrect information)

County:

Coffey

Location listed as:

Section-Township-Range:

5 & 6 - 19 S - 16 E

Fraction ($\frac{1}{4}$ $\frac{1}{4}$ $\frac{1}{4}$):

None Given

Location changed to:

6 - 19 S - 16 E

NW NW SE NE

Other changes: Initial statements:

Changed to:

Comments:

verification method:

Latitude & longitude, KGS' "LEO" conversion tool,
and mapping tool & aerial photos on KGS website.

initials:

DRL

date:

9/3/2008

submitted by: Kansas Geological Survey, Data Resources Library, 1930 Constant Ave., Lawrence, KS 66047-3726

to: Kansas Dept of Health & Environment, Bureau of Water, 1000 SW Jackson, Suite 420, Topeka, KS 66612-1367.

38° 25' 47.197"

95° 40' 41.442"

WATER WELL PLUGGING RECORD

Form WWC-5P

KSA 82a-1212

ID NO.

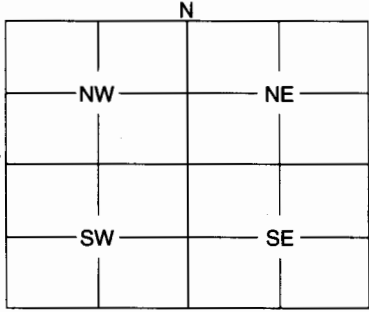
MW-4

1	LOCATION OF WATER WELL:	Fraction SEE ABOVE LAT/LONG 1/4 1/4 1/4	Section Number 5 + 6	Township Number 195	Range Number 16E	E/W
County: COFFEY						

Distance and direction from nearest town or city street address of well if located within city?

LOCATED @ FORMER ATLAS S-3 LF : FUDS # BØTKSØ2Ø1

2	WATER WELL OWNER: US Army Corps of Engineers	RR #, St. Address, Box #: 601 E 12th St.	Board of Agriculture, Division of Water Resources
City, State, ZIP Code: Kansas City Mo. 64106		Application Number:	

3	MARK WELL'S LOCATION WITH AN "X" IN SECTION BOX:	4	DEPTH OF WELL 100.5 ft. TOC 98.1 Ft BGS												
		WELL'S STATIC WATER LEVEL 77.2 ft. TOC													
WELL WAS USED AS:															
<table><tr><td>1 Domestic</td><td>5 Public Water Supply</td><td>9 Dewatering</td></tr><tr><td>2 Irrigation</td><td>6 Oil Field Water Supply</td><td>10 Monitoring Well</td></tr><tr><td>3 Feedlot</td><td>7 Domestic (Lawn & Garden)</td><td>11 Injection Well</td></tr><tr><td>4 Industrial</td><td>8 Air Conditioning</td><td>12 Other</td></tr></table>				1 Domestic	5 Public Water Supply	9 Dewatering	2 Irrigation	6 Oil Field Water Supply	10 Monitoring Well	3 Feedlot	7 Domestic (Lawn & Garden)	11 Injection Well	4 Industrial	8 Air Conditioning	12 Other
1 Domestic	5 Public Water Supply	9 Dewatering													
2 Irrigation	6 Oil Field Water Supply	10 Monitoring Well													
3 Feedlot	7 Domestic (Lawn & Garden)	11 Injection Well													
4 Industrial	8 Air Conditioning	12 Other													
Was a chemical / bacteriological sample submitted to Department? Yes No X															
If yes, mo/day/yr sample was submitted															
Water Well Disinfected: Yes No X															

5	TYPE OF BLANK CASING USED:										
<table><tr><td>1 Steel</td><td>3 RMP (SR)</td><td>5 Wrought</td><td>7 Fiberglass</td><td>9 Other (Specify below)</td></tr><tr><td>2 PVC</td><td>4 ABS</td><td>6 Asbestos-Cement</td><td>8 Concrete Tile</td><td></td></tr></table>		1 Steel	3 RMP (SR)	5 Wrought	7 Fiberglass	9 Other (Specify below)	2 PVC	4 ABS	6 Asbestos-Cement	8 Concrete Tile	
1 Steel	3 RMP (SR)	5 Wrought	7 Fiberglass	9 Other (Specify below)							
2 PVC	4 ABS	6 Asbestos-Cement	8 Concrete Tile								
Blank casing diameter 3 in. Was casing pulled? Yes X No											
Casing height above or below land surface 29 ft. in. If yes, how much 9.0 feet											

6	GROUT PLUG MATERIAL: 1 Neat cement 2 Cement grout 3 Bentonite 4 Other																				
Grout Plug Intervals: From 100.5 ft. to 3.0 ft. From ft. to ft. From ft. to ft.																					
What is the nearest source of possible contamination:																					
<table><tr><td>1 Septic tank</td><td>6 Seepage pit</td><td>11 Fuel storage</td><td>16 Other (specify below)</td></tr><tr><td>2 Sewer lines</td><td>7 Pit privy</td><td>12 Fertilizer storage</td><td></td></tr><tr><td>3 Watertight sewer lines</td><td>8 Sewage lagoon</td><td>13 Insecticide storage</td><td></td></tr><tr><td>4 Lateral lines</td><td>9 Feedyard</td><td>14 Abandoned water well</td><td></td></tr><tr><td>5 Cess pool</td><td>10 Livestock pens</td><td>15 Oil well/Gas well</td><td></td></tr></table>		1 Septic tank	6 Seepage pit	11 Fuel storage	16 Other (specify below)	2 Sewer lines	7 Pit privy	12 Fertilizer storage		3 Watertight sewer lines	8 Sewage lagoon	13 Insecticide storage		4 Lateral lines	9 Feedyard	14 Abandoned water well		5 Cess pool	10 Livestock pens	15 Oil well/Gas well	
1 Septic tank	6 Seepage pit	11 Fuel storage	16 Other (specify below)																		
2 Sewer lines	7 Pit privy	12 Fertilizer storage																			
3 Watertight sewer lines	8 Sewage lagoon	13 Insecticide storage																			
4 Lateral lines	9 Feedyard	14 Abandoned water well																			
5 Cess pool	10 Livestock pens	15 Oil well/Gas well																			
Direction from well? NA How many feet? NA																					

FROM	TO	PLUGGING MATERIALS
0	3	Native Soil
3	100.5	Cement Grout

7	CONTRACTOR'S OF LANDOWNER'S CERTIFICATION: This water well was plugged under my jurisdiction and was completed on (mo/day/year) 30 July 2008 and this record is true to the best of my knowledge and belief. Kansas Water Well Contractor's License No. NA This Water Well Record was completed on (mo/day/year) 05 Aug 2008 under the business name of US Army Corps of Engineers by (signature) [Signature]
---	---

INSTRUCTIONS: Use typewriter or ball point pen. Please press firmly and print clearly. Please fill in blanks, underline or circle the correct answers. Send top three copies to Kansas Department of Health and Environment, Bureau of Water, Geology Section, 1000 SW Jackson St., Ste. 420, Topeka, Kansas 66612-1367. Telephone: 785/296-5522. Send one to Water Well Owner and retain one for your records.