


LOCATION OF WATER WELL: Fraction SW 1/4 NW 1/4 NE 1/4 Section Number 34 Township Number T 19 S Range Number R 2 EW

Distance and direction from nearest town or city street address of well if located within city?  
500 N Adams, Hillsboro water Treatment Plant

WATER WELL OWNER: City of Hillsboro  
RR#, St. Address, Box #: 118 E Grand  
City, State, ZIP Code: Hillsboro KS 67063  
Board of Agriculture, Division of Water Resources  
Application Number:

LOCATE WELL'S LOCATION WITH AN "X" IN SECTION BOX:

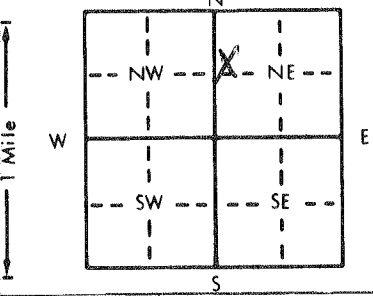

DEPTH OF COMPLETED WELL: 28 ft. ELEVATION:  
Depth(s) Groundwater Encountered 1. 29 ft. 2. ft. 3. ft.  
WELL'S STATIC WATER LEVEL: 17.05 ft. below land surface measured on mo/day/yr 4-9-96  
Pump test data: Well water was ft. after hours pumping gpm  
Est. Yield gpm: Well water was ft. after hours pumping gpm  
Bore Hole Diameter: 8 in. to ft., and in. to ft.  
WELL WATER TO BE USED AS:  
1 Domestic 3 Feedlot 6 Oil field water supply 9 Dewatering 12 Other (Specify below)  
2 Irrigation 4 Industrial 7 Lawn and garden only 10 Monitoring well  
Was a chemical/bacteriological sample submitted to Department? Yes No X; If yes, mo/day/yr sample was submitted  
Water Well Disinfected? Yes No X

TYPE OF BLANK CASING USED:  
1 Steel 3 RMP (SR) 5 Wrought iron 8 Concrete tile CASING JOINTS: Glued Clamped  
2 PVC 4 ABS 6 Asbestos-Cement 9 Other (specify below) Welded  
Blank casing diameter 2 in. to ft., Dia. in. to ft., Dia. in. to ft.  
Casing height above land surface: Flush in., weight 70.3 lbs./ft. Wall thickness or gauge No. Sch 40  
TYPE OF SCREEN OR PERFORATION MATERIAL:  
1 Steel 3 Stainless steel 5 Fiberglass 8 RMP (SR) 11 Other (specify)  
2 Brass 4 Galvanized steel 6 Concrete tile 9 ABS 12 None used (open hole)

SCREEN OR PERFORATION OPENINGS ARE:  
1 Continuous slot 3 Mill slot 5 Gauzed wrapped 8 Saw cut 11 None (open hole)  
2 Louvered shutter 4 Key punched 6 Wire wrapped 9 Drilled holes  
SCREEN-PERFORATED INTERVALS: From 13 ft. to 28 ft., From ft. to ft.  
GRAVEL PACK INTERVALS: From 10 ft. to 28 ft., From ft. to ft.

GROUT MATERIAL: 1 Neat cement 2 Cement grout 3 Bentonite 4 Other  
Grout Intervals: From 2 ft. to 10 ft., From ft. to ft., From ft. to ft.  
What is the nearest source of possible contamination:  
1 Septic tank 4 Lateral lines 7 Pit privy 10 Livestock pens 14 Abandoned water well  
2 Sewer lines 5 Cess pool 8 Sewage lagoon 11 Fuel storage 15 Oil well/Gas well  
3 Watertight sewer lines 6 Seepage pit 9 Feedyard 12 Fertilizer storage 16 Other (specify below)  
13 Insecticide storage  
Direction from well? S How many feet? 165

FROM	TO	LITHOLOGIC LOG	FROM	TO	PLUGGING INTERVALS
0	0.5	Top soil, silty, clayey			
0.5	4.5	Weathered shale			
4.5	16	Shale			
16	16.5	Limestone			
16.5	28	Shale			

CONTRACTOR'S OR LANDOWNER'S CERTIFICATION: This water well was (1) constructed (2) reconstructed, or (3) plugged under my jurisdiction and was completed on (mo/day/year) 4-26-96 and this record is true to the best of my knowledge and belief. Kansas Water Well Contractor's License No. 531 This Water Well Record was completed on (mo/day/yr) 5-24-96 under the business name of GSI by (signature) Allison Jewer