WATER WELL PLUGGING RECORD Form WWC-5P KSA 82a-1212 ID NO.

1 LOCATION OF WATER WELL:	Fraction	Section Number	Township Number	Range Number
County: Marion	NE ¼ SW ¼ NW ¼	34	19	2 E/W

Distance and direction from nearest town or city street address of well if located within city?

2 WATER WELL OWNER: City of Hillsboro

RR #, St. Address, Box #: 118 E Grand

City, State, ZIP Code : Hillsboro, Ks 67063

Board of Agriculture, Division of Water Resources

Application Number:

3 MARK WELL'S LOCATION WITH AN "X" IN SECTION BOX:

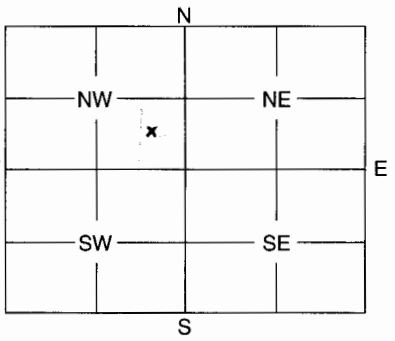

4 DEPTH OF WELL 70 ft.

WELL'S STATIC WATER LEVEL 0 ft.

WELL WAS USED AS:

1 Domestic
2 Irrigation
3 Feedlot
4 Industrial
5 Public Water Supply
6 Oil Field Water Supply
7 Domestic (Lawn & Garden)
8 Air Conditioning
9 Dewatering
10 Monitoring Well
11 Injection Well
12 Other

Was a chemical / bacteriological sample submitted to Department? Yes ..... No X

If yes, mo/day/yr sample was submitted .....

Water Well Disinfected: Yes X No .....

5 TYPE OF BLANK CASING USED:

1 Steel
2 PVC
3 RMP (SR)
4 ABS
5 Wrought
6 Asbestos-Cement
7 Fiberglass
8 Concrete Tile
9 Other (Specify below)

Blank casing diameter 10 in. Was casing pulled? Yes ..... No X If yes, how much .....

Casing height above or below land surface 48 in.

6 GROUT PLUG MATERIAL: 1 Neat cement 2 Cement grout 3 Bentonite 4 Other Chlorinated Sand - top soil

Grout Plug Intervals: From 0 ft. to 5 ft., From 5 ft. to 25 ft., From 25 to 70 ft.

What is the nearest source of possible contamination: TOP SOIL Neat Cement Chlorinated Sand

1 Septic tank
2 Sewer lines
3 Watertight sewer lines
4 Lateral lines
5 Cess pool
6 Seepage pit
7 Pit privy
8 Sewage lagoon
9 Feedyard
10 Livestock pens
11 Fuel storage
12 Fertilizer storage
13 Insecticide storage
14 Abandoned water well
15 Oil well/Gas well
16 Other (specify below) plugged well

Direction from well? East How many feet? 600

FROM	TO	PLUGGING MATERIALS
0	5	Top Soil
5	25	Neat Cement
25	70	Chlorinated Sand

7 CONTRACTOR'S OF LANDOWNER'S CERTIFICATION: This water well was plugged under my jurisdiction and was completed on (mo/day/year) 4-9-08 and this record is true to the best of my knowledge and belief. Kansas Water Well Contractor's License No. 134 This Water Well Record was completed on (mo/day/year) 6-10-08 under the business name of Rosencrantz Bemis Ent by (signature) Teresa Dodson

INSTRUCTIONS: Use typewriter or ball point pen. Please press firmly and print clearly. Please fill in blanks, underline or circle the correct answers. Send top three copies to Kansas Department of Health and Environment, Bureau of Water, Geology Section, 1000 SW Jackson St., Ste. 420, Topeka, Kansas 66612-1367. Telephone: 785/296-5522. Send one to Water Well Owner and retain one for your records.