

MW 19

WATER WELL PLUGGING RECORD Form WWC-5P

KSA 82a-1212

ID NO.


1 LOCATION OF WATER WELL: County: <u>MARION</u>	Fraction <u>SE 1/4 SW 1/4 SW 1/4</u>	Section Number <u>34</u>	Township Number <u>19</u>	Range Number <u>2</u> <u>EW</u>
--	---	-----------------------------	------------------------------	------------------------------------

Distance and direction from nearest town or city street address of well if located within city?

200 East D Street Hillsboro KS

2 WATER WELL OWNER: <u>Herb Terrill</u> RR#, St. Address, Box #: <u>TRILAKES PETROLUM</u> City, State ZIP Code: <u>PO BOX 7500</u> <u>BRANSON, MO</u>	Global Positioning Systems (decimal degrees, min. of 4 digits) Latitude: <u>38.34816</u> Longitude: <u>97.20300</u> Elevation: <u>1419.64</u> Datum: _____ Data Collection Method: <u>GPS</u>
--	--

3 MARK WELL'S LOCATION WITH AN "X" IN SECTION BOX:

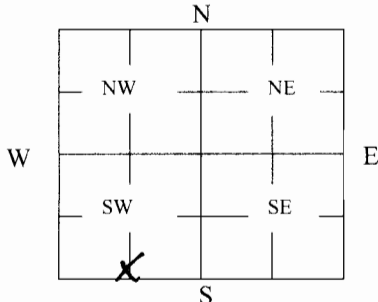

4 DEPTH OF WELL 35' ft.

WELL'S STATIC WATER LEVEL 9.0 ft

WELL WAS USED AS:

- | | | |
|--------------|----------------------------|----------------------|
| 1 Domestic | 5 Public Water Supply | 9 Dewatering |
| 2 Irrigation | 6 Oil Field Water Supply | <u>10 Monitoring</u> |
| 3 Feedlot | 7 Domestic (Lawn & Garden) | 11 Injection Well |
| 4 Industrial | 8 Air Conditioning | 12 Other _____ |

Was a chemical/bacteriological sample submitted to Department? Yes _____ No X

5 TYPE OF BLANK CASING USED:

- | | | | | |
|--------------|------------|-------------------|-----------------|-------------------------|
| 1 Steel | 3 RMP (SR) | 5 Wrought | 7 Fiberglass | 9 Other (Specify below) |
| <u>2 PVC</u> | 4 ABS | 6 Asbestos-Cement | 8 Concrete Tile | |

Blank casing diameter 2 in. Was casing pulled? Yes X No _____ If yes, how much 3'
Casing height above or below land surface -3.12' in.

6 GROUT PLUG MATERIAL: 1 Neat cement 2 Cement grout 3 Bentonite 4 Other _____

Grout Plug Intervals: From 35 ft. to 1 ft., From 1 ft. to 0 ft., From _____ to _____ ft.

What is the nearest source of possible contamination:

- | | | | |
|--------------------------|-------------------|-------------------------|---------------------------------|
| 1 Septic tank | 6 Seepage pit | 11 Fuel Storage | <u>16 Other (specify below)</u> |
| 2 Sewer lines | 7 Pit privy | 12 Fertilizer storage | <u>LOST SITE</u> |
| 3 Watertight sewer lines | 8 Sewage lagoon | 13 Insecticide storage | |
| 4 Lateral lines | 9 Feedyard | 14 Abandoned water well | Direction from well? _____ |
| 5 Cess pool | 10 Livestock pens | 15 Oil well/Gas well | How many feet? _____ |

FROM	TO	PLUGGING MATERIALS	FROM	TO	PLUGGING MATERIALS
<u>30</u>	<u>1</u>	<u>BENTONITE</u>			
<u>1</u>	<u>SURFACE</u>	<u>QUICK CRETE</u>			

7 CONTRACTOR'S OR LANDOWNER'S CERTIFICATION: This water well was plugged under my jurisdiction and was completed on (mo/day/year) 6/3/09 and this record is true to the best of my knowledge and belief. Kansas Water Well Contractor's License No. _____. This Water Well Record was completed on (mo/day/year) 6/4/09 under the business name of TANK Management Services by (signature) Chad M. [Signature]

INSTRUCTIONS: Use typewriter or ballpoint pen. Please press firmly and print clearly. Please fill in blanks, underline or circle the correct answers. Send top three copies to Kansas Department of Health and Environment, Bureau of Water, Geology Section, 1000 SW Jackson St., Ste. 420, Topeka, Kansas 66612-1367. Telephone: 785/296-5522. Send one to Water Well Owner and retain one for your records. Visit us at http://www.kdheks.gov/geo/waterwells.

TRITERRA LAND SERVICES

P.O. Box 546
Clearwater, Kansas 67026
Office (620) 584-2313 Cell (316) 648-3617
Fax (620) 584-4371
E-mail: triterrals@yahoo.com

COPY

SURVEYING OF MONITORING WELLS PRIME TIME #124 HILLSBORO, KANSAS

The above site is in Section 34, Township 19 South, Range 2 East of the Sixth Principal Meridian, Marion County, Kansas. The Southeast corner of Section 34 was assigned coordinates of 00.00 North and 00.00 West.

The vertical control was a previously installed control point on-site described as: an 'x' cut in the concrete at the west end of the south pump island.

The Latitude and Longitude were recorded from a GPS unit. The site is located on the 7.5' quad map titled "Hillsboro".

ID	NORTH	WEST	LATITUDE	LONGITUDE	ELEVATION
SE CORNER 34-19S-2E	00.00	00.00			
Control Point	55.00	4385.00	38.34808	97.20295	1420.74
MW-14 SW SE SW SW	126.00	4446.00	38.34836	97.20316	RIM 1420.32 TOC 1420.05
MW-18 SW SE SW SW	90.81	4405.82	38.34825	97.20302	RIM 1420.54 TOC 1420.33
MW-19 SW SE SW SW	50.21	4405.73	38.34816	97.20300	RIM 1419.90 TOC 1419.64
MW-20 SW SE SW SW	81.57	4337.74	38.34821	97.20277	RIM 1420.72 TOC 1420.41
MW-21 SW SE SW SW	53.91	4337.78	38.34816	97.20278	RIM 1420.26 TOC 1419.94

