


D77?

1 LOCATION OF WATER WELL: Fraction NC 1/4 NC 1/4 SE 1/4 Section Number 34 Township Number T 19 S Range Number R 2 E  
 County: Marion

Distance and direction from nearest town or city street address of well if located within city?  
In City Hillsboro 406 Briarwood hme Carriage Hills. Add

2 WATER WELL OWNER: Dartell Driggers  
 RR#, St. Address, Box #: 406 Briarwood hme Board of Agriculture, Division of Water Resources  
 City, State, ZIP Code: Hillsboro, Ks. 67063 Application Number:

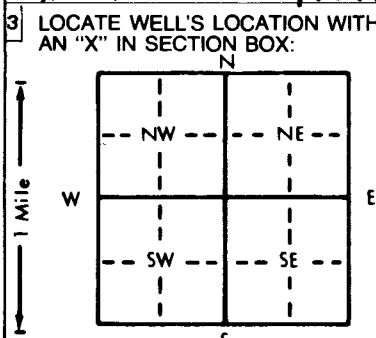

4 DEPTH OF COMPLETED WELL: 57 ft. ELEVATION:  
 Depth(s) Groundwater Encountered 1. 30 ft. 2. 55 ft. 3. ft.  
 WELL'S STATIC WATER LEVEL 14 ft. below land surface measured on mo/day/yr 7-16-98  
 Pump test data: Well water was ft. after hours pumping gpm  
 Est. Yield 25 gpm Well water was ft. after hours pumping gpm  
 Bore Hole Diameter 9 in. to 57 ft., and in. to ft.  
 WELL WATER TO BE USED AS:  
 5 Public water supply 8 Air conditioning 11 Injection well  
 1 Domestic 3 Feedlot 6 Oil field water supply 9 Dewatering 12 Other (Specify below)  
 2 Irrigation 4 Industrial 7 Lawn and garden only 10 Monitoring well  
 Was a chemical/bacteriological sample submitted to Department? Yes No ; If yes, mo/day/yr sample was submitted  
 Water Well Disinfected? Yes  No

5 TYPE OF CASING USED:  
 1 Steel 3 RMP (SR) 5 Wrought iron 8 Concrete tile CASING JOINTS: Glued  Clamped   
 2 PVC 4 ABS 6 Asbestos-Cement 9 Other (specify below) Welded   
 7 Fiberglass Threaded   
 Blank casing diameter 5 in. to 30 ft., Dia in. to ft., Dia in. to ft.  
 Casing height above land surface 12 in., weight Class 160 lbs./ft. Wall thickness or gauge No. 214  
 TYPE OF SCREEN OR PERFORATION MATERIAL:  
 1 Steel 3 Stainless steel 5 Fiberglass 7 PVC 10 Asbestos-cement  
 2 Brass 4 Galvanized steel 6 Concrete tile 8 RMP (SR) 11 Other (specify)   
 9 ABS 12 None used (open hole)  
 SCREEN OR PERFORATION OPENINGS ARE:  
 1 Continuous slot 3 Mill slot 5 Gauzed wrapped 8 Saw cut 11 None (open hole)  
 2 Louvered shutter 4 Key punched 6 Wire wrapped 9 Drilled holes  
 7 Torch cut 10 Other (specify)   
 SCREEN-PERFORATED INTERVALS: From 30 ft. to 57 ft., From ft. to ft. ft.  
 From ft. to ft. ft., From ft. to ft. ft.  
 GRAVEL PACK INTERVALS: From ft. to ft. ft., From ft. to ft. ft.  
 From ft. to ft. ft., From ft. to ft. ft.

6 GROUT MATERIAL: 1 Neat cement 2 Cement grout 3 Bentonite 4 Other   
 Grout Intervals: From 0 ft. to 20 ft., From ft. to ft. ft., From ft. to ft. ft.  
 What is the nearest source of possible contamination:  
 1 Septic tank 4 Lateral lines 7 Pit privy 10 Livestock pens 14 Abandoned water well  
 2 Sewer lines 5 Cess pool 8 Sewage lagoon 11 Fuel storage 15 Oil well/Gas well  
 3 Watertight sewer lines 6 Seepage pit 9 Feedyard 12 Fertilizer storage 16 Other (specify below)  
 13 Insecticide storage  
 Direction from well? W How many feet? 50 +

FROM	TO	LITHOLOGIC LOG	FROM	TO	PLUGGING INTERVALS
0	31	Clay			
21	30	Blue-Gray Clay			
30	32	Crumbled Shale			
32	55	Blue Shale			
55	56	Water			
56	57	Gray Shale			

7 CONTRACTOR'S OR LANDOWNER'S CERTIFICATION: This water well was (1) constructed, (2) reconstructed, or (3) plugged under my jurisdiction and was completed on (mo/day/year) 7-16-98 and this record is true to the best of my knowledge and belief. Kansas  
 Water Well Contractor's License No. 780 This Water Well Record was completed on (mo/day/yr) 7-27-98  
 under the business name of Backhoe Drilling by (signature) Paul H. Backhoe

INSTRUCTIONS: Use typewriter or ball point pen. PLEASE PRESS FIRMLY and PRINT clearly. Please fill in blanks, underline or circle the correct answers. Send top three copies to Kansas Department of Health and Environment, Bureau of Water, Topeka, Kansas 66620-0001. Telephone: 913-296-5545. Send one to WATER WELL OWNER and retain one for your records.

OFFICE USE ONLY  
T  
R  
EW  
SEC.  
1/4  
1/4  
1/4