


MW-3

WATER WELL RECORD Form WWC-5 KSA 82a-1212

1 LOCATION OF WATER WELL: Fraction NE 1/4 NE 1/4 SW 1/4 Section Number 34 Township Number T 19 S Range Number R 2 EW
 County: Marion
 Distance and direction from nearest town or city street address of well if located within city? 812 E A Street

2 WATER WELL OWNER: USO 410
 RR#, St. Address, Box #: 812 East A Street Board of Agriculture, Division of Water Resources
 City, State, ZIP Code: Willsboro, KS 67063 Application Number:

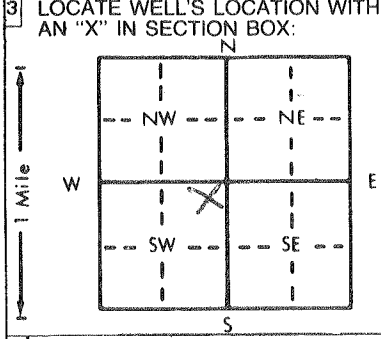

4 DEPTH OF COMPLETED WELL: 45 ft. ELEVATION: —
 Depth(s) Groundwater Encountered 1. 2.39 ft. 2. — ft. 3. — ft.
 WELL'S STATIC WATER LEVEL 33.49 ft. below land surface measured on mo/day/yr 8/13/98
 Pump test data: Well water was — ft. after — hours pumping — gpm
 Est. Yield — gpm Well water was — ft. after — hours pumping — gpm
 Bore Hole Diameter 8.625 in. to 45 ft., and — in. to — ft.
 WELL WATER TO BE USED AS:
 1 Domestic — 3 Feedlot — 6 Oil field water supply — 9 Dewatering — 11 Injection well —
 2 Irrigation — 4 Industrial — 7 Lawn and garden only — 10 Monitoring well MW-3 12 Other (Specify below)
 Was a chemical/bacteriological sample submitted to Department? Yes — No X; If yes, mo/day/yr sample was submitted
 Water Well Disinfected? Yes — No X

5 TYPE OF BLANK CASING USED:
 1 Steel — 3 RMP (SR) — 5 Wrought iron — 8 Concrete tile — CASING JOINTS: Glued — Clamped —
 2 PVC — 4 ABS — 6 Asbestos-Cement — 9 Other (specify below) — Welded —
 7 Fiberglass — Threaded X
 Blank casing diameter 2 in. to 30 ft., Dia. — in. to — ft., Dia. — in. to — ft.
 Casing height above land surface Flush in., weight SCN 40 lbs./ft. Wall thickness or gauge No. —
 TYPE OF SCREEN OR PERFORATION MATERIAL:
 1 Steel — 3 Stainless steel — 5 Fiberglass — 8 RMP (SR) — 10 Asbestos-cement —
 2 Brass — 4 Galvanized steel — 6 Concrete tile — 9 ABS — 11 Other (specify) —
 12 None used (open hole) —
 SCREEN OR PERFORATION OPENINGS ARE:
 1 Continuous slot — 5 Gauzed wrapped — 8 Saw cut — 11 None (open hole) —
 2 Louvered shutter — 6 Wire wrapped — 9 Drilled holes —
 4 Key punched — 7 Torch cut — 10 Other (specify) —
 SCREEN-PERFORATED INTERVALS: From 30 ft. to 45 ft., From — ft. to — ft., From — ft. to — ft.
 GRAVEL PACK INTERVALS: From 28.5 ft. to 45 ft., From — ft. to — ft., From — ft. to — ft.

6 GROUT MATERIAL: 1 Neat cement — 2 Cement grout — 3 Bentonite — 4 Other —
 Grout Intervals: 2 From 0 ft. to 26 ft., From 26 ft. to 28.5 ft., From — ft. to — ft.
 What is the nearest source of possible contamination:
 1 Septic tank — 4 Lateral lines — 7 Pit privy — 10 Livestock pens — 14 Abandoned water well —
 2 Sewer lines — 5 Cess pool — 8 Sewage lagoon — 11 Fuel storage — 15 Oil well/Gas well —
 3 Watertight sewer lines — 6 Seepage pit — 9 Feedyard — 12 Fertilizer storage — 16 Other (specify below) Contaminated site
 13 Insecticide storage —
 Direction from well? How many feet?

FROM	TO	LITHOLOGIC LOG	FROM	TO	PLUGGING INTERVALS
0	5	Rock 3 Soil Fill			
5	35	silty clay			
35	45	shale			
45	TD	end of Borehole			

7 CONTRACTOR'S OR LANDOWNER'S CERTIFICATION: This water well was (1) constructed, (2) reconstructed, or (3) plugged under my jurisdiction and was completed on (mo/day/year) 8/11/98 and this record is true to the best of my knowledge and belief. Kansas Water Well Contractor's License No. 085 This Water Well Record was completed on (mo/day/yr) — under the business name of AEI by (signature)

INSTRUCTIONS: Use typewriter or ball point pen. PLEASE PRESS FIRMLY and PRINT clearly. Please fill in blanks, underline or circle the correct answers. Send top three copies to Kansas Department of Health and Environment, Bureau of Water, Topeka, Kansas 66620-0001. Telephone: 913-296-5545. Send one to WATER WELL OWNER and retain one for your records.