


Marion

SW SW NW SW

34-19-2E

MAIN STREET

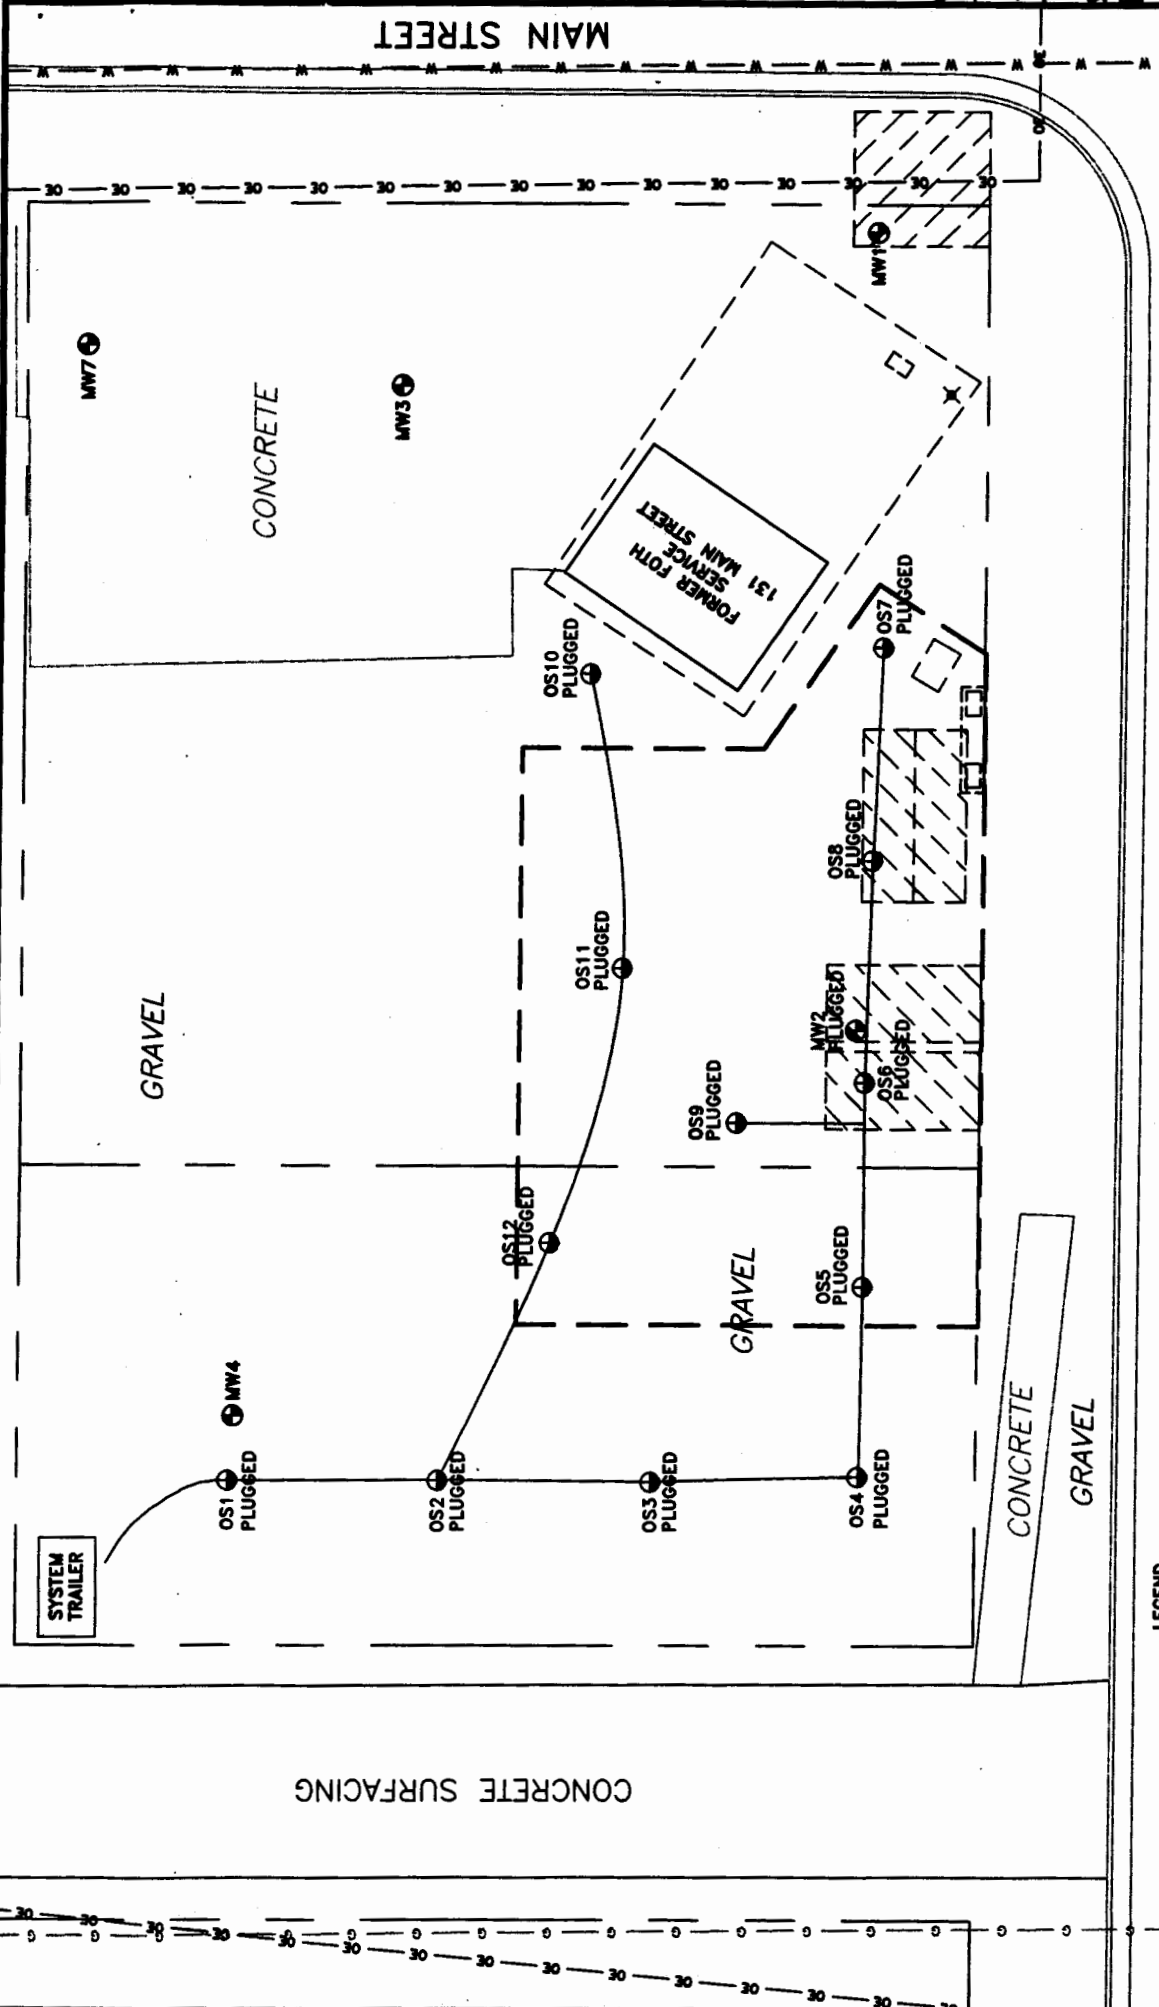

GEOCORE INC.

P.O. BOX 386 (785) 826-1616 SALINA, KANSAS

FIGURE 1: SITE BASE MAP GEOCORE PROJECT NO. 1549

SITE: FORMER FOTH SERVICE	CREATED: 01/08/10
LOCATION: HILLSBORO, KANSAS	SCALE: 1"=20'
LEGAL: SW, SW, NW, SW	DRAFTER: DCM
SEC 34, T19S, R2E	FIGURE:
KDHE PROJECT CODE: US-057-00280	FOTH.DWG

- LEGEND**
- FORMER UST TANKS - 2010
 - FORMER UST TANKS - 2003
 - EXCAVATION - 2010
 - CANOPY
 - FORMER DISPENSER PUMPS
 - OVERHEAD ELECTRIC
 - GAS LINE
 - TELEPHONE
 - WATER LINE
 - SYSTEM LINE

A STREET

MONITORING WELL
OXYGEN INJECTION WELL

SCALE: 1" = 20'