


1 LOCATION OF WATER WELL: County Miami Fraction NW 1/4 NW 1/4 NW 1/4 Section Number 10 Township Number T 17 S Range Number R 23 EW

Distance and direction from nearest town or city street address of well if located within city?  
371 1/2 East of Hodge Lane South Side

2 WATER WELL OWNER: Miami County RR#, St. Address, Box # PO Box 445 Board of Agriculture, Division of Water Resources  
 City, State, ZIP Code Doan Kansas 66071 Application Number:

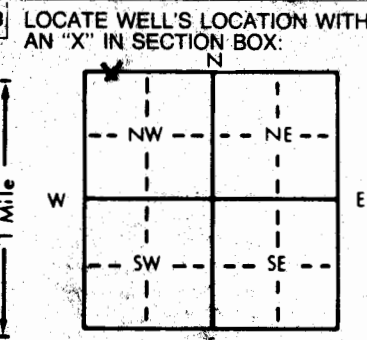

4 DEPTH OF COMPLETED WELL 15'-0" ft. ELEVATION  
 Depth(s) Groundwater Encountered 1. 8'-0" ft. 2. ft. 3. ft.  
 WELL'S STATIC WATER LEVEL 8'-0" ft. below land surface measured on mo/day/yr 11-5-92  
 Pump test data: Well water was ft. after hours pumping gpm  
 Est. Yield gpm: Well water was ft. after hours pumping gpm  
 Bore Hole Diameter in. to ft., and in. to ft.  
 WELL WATER TO BE USED AS:  
 1 Domestic 3 Feedlot 6 Oil field water supply 9 Dewatering 11 Injection well  
 2 Irrigation 4 Industrial 7 Lawn and garden only 10 Monitoring well Abandoned (dry) Well  
 Was a chemical/bacteriological sample submitted to Department? Yes No  No; If yes, mo/day/yr sample was submitted  
 Water Well Disinfected?  Yes No

5 TYPE OF BLANK CASING USED:  
 1 Steel 3 RMP (SR) 5 Wrought iron 8 Concrete tile CASING JOINTS: Glued Clamped  
 2 PVC 4 ABS 6 Asbestos-Cement 9 Other (specify below) Rock Welded  
 7 Fiberglass Threaded  
 Blank casing diameter 4 1/2" in. to ft. Dia. in. to ft. Dia. in. to ft. Dia. in. to ft.  
 Casing height above land surface 90" in., weight lbs./ft. Wall thickness or gauge No.

TYPE OF SCREEN OR PERFORATION MATERIAL:  
 1 Steel 3 Stainless steel 5 Fiberglass 7 PVC 10 Asbestos-cement  
 2 Brass 4 Galvanized steel 6 Concrete tile 8 RMP (SR) 11 Other (specify) NA  
 9 ABS 12 None used (open hole)

SCREEN OR PERFORATION OPENINGS ARE:  
 1 Continuous slot 3 Mill slot 5 Gauzed wrapped 8 Saw cut 11 None (open hole)  
 2 Louvered shutter 4 Key punched NA 6 Wire wrapped 9 Drilled holes  
 7 Torch cut 10 Other (specify) NA

SCREEN-PERFORATED INTERVALS: From NA ft. to NA ft. From ft. to ft. From ft. to ft. From ft. to ft.  
 GRAVEL PACK INTERVALS: From ft. to ft. From ft. to ft. From ft. to ft. From ft. to ft.

6 GROUT MATERIAL: 1 Neat cement 2 Cement grout 3 Bentonite 4 Other  
 Grout intervals: From 1 ft. to ft. From 8'-0" ft. to 7'-6" ft. From ft. to ft.

What is the nearest source of possible contamination:  
 1 Septic tank 4 Lateral lines 7 Pit privy 10 Livestock pens 14 Abandoned water well  
 2 Sewer lines 5 Cess pool 8 Sewage lagoon 11 Fuel storage 15 Oil well/Gas well  
 3 Watertight sewer lines 6 Seepage pit 9 Feedyard 12 Fertilizer storage 16 Other (specify below)  
 13 Insecticide storage  
 Direction from well? How many feet?

FROM	TO	LITHOLOGIC LOG	FROM	TO	PLUGGING INTERVALS
			15'	8'	Rock and 2" Clean Rock
			8'	7'-6"	Bentonite
			7'-6"		CLAY FILL

7 CONTRACTOR'S OR LANDOWNER'S CERTIFICATION: This water well was (1) constructed, (2) reconstructed, or (3) plugged under my jurisdiction and was completed on (mo/day/year) 11-4-92 and this record is true to the best of my knowledge and belief. Kansas  
 Water Well Contractor's License No. NA This Water Well Record was completed on (mo/day/yr) 11-9-92  
 under the business name of Miami County KS by (signature) J.R. McMath

OFFICE USE ONLY

SEC