WATER WELL RECORD Form WWC-5 KSA 82a-1212

1 LOCATION OF WATER WELL: County: **Linn** | Fraction: ¼ **SE** ¼ **SE** ¼ | Section Number: **33** | Township Number: T **19** S | Range Number: R **24** E

Distance and direction from nearest town or city street address of well if located within city?
402 E. Market Street, La Cygne, Kansas

2 WATER WELL OWNER: **Wades Service and Deli**
RR#, St. Address, Box # : **402 E. Market Street**
City, State, ZIP Code : **La Cygne, Kansas**
Board of Agriculture, Division of Water Resources
Application Number:

3 LOCATE WELL'S LOCATON WITH AN "X" IN SECTION BOX:

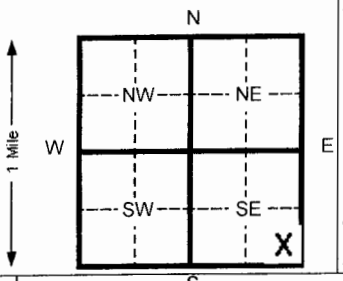

4 DEPTH OF COMPLETED WELL **40** ft. ELEVATION:
Depth(s) Groundwater Encountered 1 1.5 ft. 2 ft. 3 Ft.
WELL'S STATIC WATER LEVEL ft. below land surface measured on mo/day/yr
Pump test data: Well water was Ft. after hours pumping Gpm
Est. Yield Gpm: Well water was Ft. after Hours pumping Gpm
Bore Hole Diameter **8.625** In. to **40** ft. and in. to Ft.
WELL WATER TO BE USED AS: 5 Public water supply 8 Air conditioning 11 Injection well
1 Domestic 3 Feed lot 6 Oil field water supply 9 Dewatering 12 Other (Specify below)
2 Irrigation 4 Industrial 7 Lawn and garden (domestic) 10 [Monitoring well] **MW-7**
Was a chemical/bacteriological sample submitted to Department? Yes No **X** If yes, mo/day/yr sample was Submitted
Water Well Disinfected? Yes No **X**

5 TYPE OF BLANK CASING USED: 5 Wrought Iron 8 Concrete tile CASING JOINTS: Glued Clamped
1 Steel 3 RMP (SR) 6 Asbestos-Cement 9 Other (specify below) Welded
2 [PVC] 4 ABS 7 Fiberglass [Threaded] **X**
Blank casing diameter **2** in. to **25** Ft., Dia In. to ft., Dia in. to ft.
Casing height above land surface **FLUSH** In., weight **SCH 40** Lbs./ft. Wall thickness or gauge No.

TYPE OF SCREEN OR PERFORATION MATERIAL: 7 [PVC] 10 Asbestos-cement
1 Steel 3 Stainless steel 5 Fiberglass 8 RMP (SR) 11 Other (specify)
2 Brass 4 Galvanized steel 6 Concrete tile 9 ABS 12 None used (open hole)

SCREEN OR PERFORATION OPENINGS ARE: 5 Gauzed wrapped 8 Saw cut 11 None (open hole)
1 Continuous slot 3 [Mill slot] 6 Wire wrapped 9 Drilled holes
2 Louvered shutter 4 Key punched 7 Torch cut 10 Other (specify)

SCREEN-PERFORATED INTERVALS: From **25** ft. to **40** ft. From ft. to ft.
From ft. to ft. From ft. to ft. From ft. to ft.
SAND PACK INTERVALS: From **24** ft. to **40** ft. From ft. to ft.
From ft. to ft. From ft. to ft. From ft. to ft.

6 GROUT MATERIAL: 1 Neat cement [2 Cement grout] [3 Bentonite] 4 Other
Grout Intervals From3 **0** ft. to **2** Ft. From2 **2** to **24** ft. From ft. to ft.

What is the nearest source of possible contamination:
1 Septic tank 4 Lateral lines 7 Pit privy 10 Livestock pens 14 Abandoned water well
2 Sewer lines 5 Cess pool 8 Sewage lagoon 11 Fuel storage 15 Oil well/ Gas well
3 Watertight sewer lines 6 Seepage pit 9 Feedyard 12 Fertilizer storage 16 [Other (specify below)]
13 Insecticide storage **Contaminated Site**
Direction from well? How many feet?

FROM	TO	CODE	LITHOLOGIC LOG	FROM	TO	PLUGGING INTERVALS
0	.5		Asphalt			
.5	3		Gravel			
3	10		Silty Clay (CL) med to lt gray			
10	15		Silty clay , lt gray to dk yellow			
15	30		Silty Clay loam			
30	35		Silt Loam, med yellow brown			
35	40		Silt loam, med, yellow br gray			
40	TD		End of Borehole			

7 CONTRACTOR'S OR LANDOWNER'S CERTIFICATION: This water well was (x) constructed, (2) reconstructed, or (3) plugged under my jurisdiction and w
Completed on (mo/day/yr) **08/15/07** And this record is true to the best of my knowledge and belief. Kansas
Water Well Contractor's License No. **585** This Water Well Record was completed on (mo/day/yr) **09/14/07**
under the business name of **Associated Environmental, Inc.** By (signature) **Bradley J Johnson**

INSTRUCTIONS.. Please fill in blanks and circle the correct answers. Send three copies to Kansas Department of Health and Environment, Bureau of Water, Topeka, Kansas 66620-0001. Telephone: 913-296-5545 Send one to WATER WELL OWNER and retain one for your records.

OFFICE USE ONLY T R SEC