



Corrected

MW-605A

WATER WELL RECORD Form WWC-5 1263662


Division of Water Resources App. No.

Well ID BEE-2A

Original Record Correction Change in Well Use

1 LOCATION OF WATER WELL: County: Linn Fraction SW 1/4 SE 1/4 SE 1/4 SW 1/4 Section Number 27 Township Number T 19 S Range Number R 25 E W

2 WELL OWNER: Last Name: First: Street or Rural Address where well is located (if unknown, distance and direction from nearest town or intersection): If at owner's address, check here: Business: KCP&L Address: 25166 E 2200th Road City: La Cygne State: KS ZIP: 66040

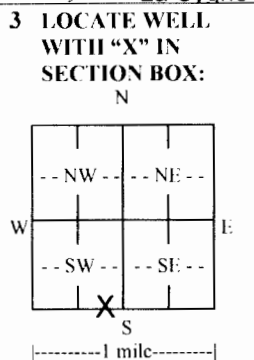

3 LOCATE WELL WITH 'X' IN SECTION BOX: N W E S 1 mile
4 DEPTH OF COMPLETED WELL: 64 ft. Depth(s) Groundwater Encountered: 1) 2) 3) 4) Dry Well
WELL'S STATIC WATER LEVEL: below land surface, measured on (mo-day-yr) above land surface, measured on (mo-day-yr)
Pump test data: Well water was after hours pumping gpm
Well water was after hours pumping gpm
Estimated Yield: gpm
Bore Hole Diameter: 6 in. to 65 ft. and in. to ft.

5 Latitude: 38.35977 (decimal degrees) Longitude: 94.63341 (decimal degrees) Datum: WGS 84 NAD 83 NAD 27
Source for Latitude/Longitude: GPS (unit make/model: (WAAS enabled? Yes No) Land Survey Topographic Map Online Mapper:
6 Elevation: 851 870.87 ft. Ground Level TOC Source: Land Survey GPS Topographic Map Other SOLAR

7 WELL WATER TO BE USED AS: 1. Domestic: Household Lawn & Garden Livestock Irrigation Feedlot Industrial
2. Public Water Supply: well ID
3. Dewatering: how many wells?
4. Aquifer Recharge: well ID
5. Monitoring: well ID BEE-2A MW-605A
6. Environmental Remediation: well ID Air Sparge Soil Vapor Extraction Recovery Injection
7. Oil Field Water Supply: lease
8. Test Hole: well ID Cased Uncased Geotechnical
9. Geothermal: how many bores? a) Closed Loop Horizontal Vertical b) Open Loop Surface Discharge Inj. of Water
10. Other (specify):

Was a chemical/bacteriological sample submitted to KDHE? Yes No If yes, date sample was submitted:
Water well disinfected? Yes No

8 TYPE OF CASING USED: Steel PVC Other CASING JOINTS: Glued Clamped Welded Threaded
Casing diameter 2 in. to 64 ft. Diameter in. to ft. Diameter in. to ft.
Casing height above land surface 36 in. Weight lbs./ft. Wall thickness or gauge No. 0.154 inch

TYPE OF SCREEN OR PERFORATION MATERIAL: Steel Stainless Steel Fiberglass PVC Brass Galvanized Steel Concrete tile None used (open hole) Other (Specify)
SCREEN OR PERFORATION OPENINGS ARE: Continuous Slot Mill Slot Gauze Wrapped Torch Cut Drilled Holes Other (Specify) Louvered Shutter Key Punched Wire Wrapped Saw Cut Nonc (Open Hole)
SCREEN-PERFORATED INTERVALS: From 59 ft. to 64 ft. From ft. to ft. From ft. to ft.
GRAVEL PACK INTERVALS: From 57 ft. to 65 ft. From ft. to ft. From ft. to ft.

9 GROUT MATERIAL: Neat cement Cement grout Bentonite Other cement-bentonite
Grout Intervals: From 1 ft. to 53.5 ft. From 53.5 ft. to 57 ft. From ft. to ft.

Nearest source of possible contamination: Septic Tank Lateral Lines Pit Privy Livestock Pens Insecticide Storage Sewer Lines Cess Pool Sewage Lagoon Fuel Storage Abandoned Water Well Watertight Sewer Lines Seepage Pit Feedyard Fertilizer Storage Oil Well/Gas Well Other (Specify)
Direction from well? Distance from well? ft.

Table with columns: 10 FROM TO LITHOLOGIC LOG FROM TO LITHO. LOG (cont.) or PLUGGING INTERVALS. Rows: 0-17 fill, 17-26.5 clay, 26.5-49.3 shale, 49.3-54 limestone, 54-65 shale.

11 CONTRACTOR'S OR LANDOWNER'S CERTIFICATION: This water well was constructed, reconstructed, or plugged under my jurisdiction and was completed on (mo-day-year) 08/17/2015 and this record is true to the best of my knowledge and belief. Kansas Water Well Contractor's License No. 529 This Water Well Record was completed on (mo-day-year) 09/08/2015 under the business name of Geotechnology, Inc.