



Corrected

MW-605D

WATER WELL RECORD Form WWC-5 1263672

Division of Water Resources App. No.

[]


BLF-2D

Original Record Correction Change in Well Use

Well ID

1 LOCATION OF WATER WELL: County: Linn Fraction SW 1/4 SE 1/4 SE 1/4 SW 1/4 Section Number 27 Township Number T 19 S Range Number R 25 E W

2 WELL OWNER: Last Name: First: Street or Rural Address where well is located Business: KCP&L Address: 25166 E 2200th Road City: La Cygne State: KS ZIP: 66040

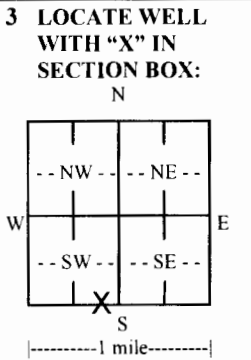

3 LOCATE WELL WITH 'X' IN SECTION BOX: 4 DEPTH OF COMPLETED WELL: 32 ft. Dry Well

5 Latitude: 38.35985 Longitude: 94.63342 Datum: WGS 84 NAD 83 NAD 27 Source for Latitude/Longitude: GPS WAAS enabled Land Survey Topographic Map Online Mapper

7 WELL WATER TO BE USED AS: 1. Domestic 2. Irrigation 3. Feedlot 4. Industrial 5. Public Water Supply 6. Dewatering 7. Aquifer Recharge 8. Monitoring 9. Environmental Remediation 10. Oil Field Water Supply 11. Test Hole 12. Geothermal 13. Other

Was a chemical/bacteriological sample submitted to KDHE? Water well disinfected?

8 TYPE OF CASING USED: Steel PVC Other CASING JOINTS: Glued Clamped Welded Threaded Casing diameter 2 in. to 32 ft. Diameter 36 in. to 154 inch

9 GROUT MATERIAL: Neat cement Cement grout Bentonite Other cement-bentonite Grout Intervals: 1 ft. to 20.5 ft. 20.5 ft. to 24 ft.

Nearest source of possible contamination: Septic Tank Lateral Lines Pit Privy Livestock Pens Insecticide Storage Sewer Lines Cess Pool Sewage Lagoon Fuel Storage Abandoned Water Well Watertight Sewer Lines Seepage Pit Feedyard Fertilizer Storage Oil Well/Gas Well

Table with columns: 10 FROM, TO, LITHOLOGIC LOG, FROM, TO, LITHO. LOG (cont.) or PLUGGING INTERVALS. Rows: 0-17 fill, 17-26.5 clay, 26.5-32 shale

11 CONTRACTOR'S OR LANDOWNER'S CERTIFICATION: This water well was constructed, reconstructed, or plugged under my jurisdiction and was completed on (mo-day-year) 08/18/2015