


1 LOCATION OF WATER WELL: Fraction Se 1/4 NW 1/4 NW 1/4 Section Number 6 Township Number T 19 S Range Number R 2 EW

County: Marion Distance and direction from nearest town or city street address of well if located within city? 4 S 2 W Durham

2 WATER WELL OWNER: Mike Arndt Board of Agriculture, Division of Water Resources
 RR#, St. Address, Box #: RR2 Box 253 Application Number:
 City, State, ZIP Code: Marion, KS 66861

3 LOCATE WELL'S LOCATION WITH AN "X" IN SECTION BOX: DEPTH OF COMPLETED WELL 110 ft. ELEVATION:
 Depth(s) Groundwater Encountered 1 18 32 ft. 2. ft. 3. ft.

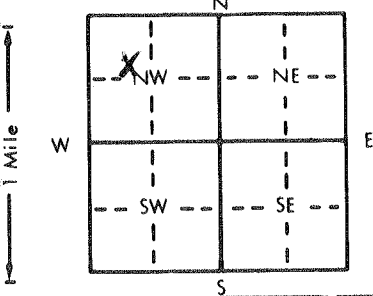

WELL'S STATIC WATER LEVEL 18 ft. below land surface measured on mo/day/yr 4-2-96
 Pump test data: Well water was _____ ft. after _____ hours pumping _____ gpm
 Est. Yield 1-3 gpm Well water was _____ ft. after _____ hours pumping _____ gpm
 Bore Hole Diameter 4 in. to 25 ft., and 7 1/2 in. to 110 ft.
 WELL WATER TO BE USED AS:
 1 Domestic 2 Irrigation 3 Feedlot 4 Industrial 5 Public water supply 6 Oil field water supply 7 Lawn and garden only 8 Air conditioning 9 Dewatering 10 Monitoring well 11 Injection well 12 Other (Specify below)
 Was a chemical/bacteriological sample submitted to Department? Yes _____ No Y If yes, mo/day/yr sample was submitted _____
 Water Well Disinfected? Yes X No

5 TYPE OF BLANK CASING USED:
 1 Steel 2 PVC 3 RMP (SR) 4 ABS 5 Wrought iron 6 Asbestos-Cement 7 Fiberglass 8 Concrete tile 9 Other (specify below) CASING JOINTS: Glued X Clamped _____
 Blank casing diameter 5 in. to 20 ft., Dia 5 in. to 70 ft., Dia _____ in. to _____ ft.
 Casing height above land surface 12 in., weight Class 160 lbs./ft. Wall thickness or gauge No. 219

TYPE OF SCREEN OR PERFORATION MATERIAL:
 1 Steel 2 Brass 3 Stainless steel 4 Galvanized steel 5 Fiberglass 6 Concrete tile 7 PVC 8 RMP (SR) 10 Asbestos-cement 11 Other (specify) _____
 SCREEN OR PERFORATION OPENINGS ARE:
 1 Continuous slot 2 Louvered shutter 3 Mill slot 4 Key punched 5 Gauzed wrapped 6 Wire wrapped 7 Torch cut 8 Saw cut 9 Drilled holes 11 None (open hole)

SCREEN-PERFORATED INTERVALS: From 20 ft. to 30 ft., From 70 ft. to 110 ft.
 GRAVEL PACK INTERVALS: From _____ ft. to _____ ft., From _____ ft. to _____ ft.

6 GROUT MATERIAL: 1 Neat cement 2 Cement grout 3 Bentonite 4 Other _____
 Grout intervals: From 0 ft. to 20 ft., From _____ ft. to _____ ft.
 What is the nearest source of possible contamination:
 1 Septic tank 2 Sewer lines 3 Watertight sewer lines 4 Lateral lines 5 Cess pool 6 Seepage pit 7 Pit privy 8 Sewage lagoon 9 Feedyard 10 Livestock pens 11 Fuel storage 12 Fertilizer storage 13 Insecticide storage 14 Abandoned water well 15 Oil well/Gas well 16 Other (specify below)
 Direction from well? NW How many feet? 100+

FROM	TO	LITHOLOGIC LOG	FROM	TO	PLUGGING INTERVALS
0	18	Clay			
18	32	Crumbled Shale			
32	68	Blue-Gray Shale			
68	72	Crumbled Shale			
72	110	Blue Shale			

7 CONTRACTOR'S OR LANDOWNER'S CERTIFICATION: This water well was (1) constructed, (2) reconstructed, or (3) plugged under my jurisdiction and was completed on (mo/day/year) 4-2-96 and this record is true to the best of my knowledge and belief. Kansas Water Well Contractor's License No. 120 This Water Well Record was completed on (mo/day/yr) 4-23-96 under the business name of Bachhus Drilling by (signature) Paul H. Bachhus

INSTRUCTIONS: Use typewriter or ball point pen. PLEASE PRESS FIRMLY and PRINT clearly. Please fill in blanks, underline or circle the correct answers. Send top three copies to Kansas Department of Health and Environment, Bureau of Water, Topeka, Kansas 66620-0001. Telephone: 913-296-5545. Send one to WATER WELL OWNER and retain one for your records.