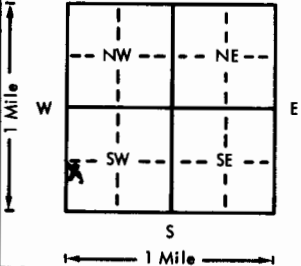


USE TYPEWRITER OR BALL POINT PEN-PRESS FIRMLY, PRINT CLEARLY.

WATER WELL RECORD
KSA 82a-1201-1215

Kansas Department of Health and Environment-Division of Environment
(Water well Contractors)
Topeka, Kansas 66620

1. Location of well: County <u>Marion</u> Fraction <u>NW 1/4 SW 1/4 SW 1/4</u> Section number <u>28</u> Township number <u>T 19 S R 3E</u> Range number <u>3E</u>	
2. Distance and direction from nearest town or city: <u>1 1/4 N</u> Street address of well location if in city: <u>Canda</u> 3. Owner of well: <u>Keith Hamsher</u> R.R. or street: <u>217 S. Jefferson</u> City, state, zip code: <u>Hillsboro, KS 67603</u>	
4. Locate with "X" in section below: Sketch map: 	
5. Type and color of material	
	6. Bore hole dia. <u>7-10</u> in. Completion date <u>7-1-76</u> Well depth <u>62</u> ft.
	7. <input checked="" type="checkbox"/> Cable tool <input type="checkbox"/> Rotary <input type="checkbox"/> Driven <input type="checkbox"/> Dug <input type="checkbox"/> Hollow rod <input type="checkbox"/> Jetted <input type="checkbox"/> Bored <input type="checkbox"/> Reverse rotary
	8. Use: <input checked="" type="checkbox"/> Domestic <input type="checkbox"/> Public supply <input type="checkbox"/> Industry <input type="checkbox"/> Irrigation <input type="checkbox"/> Air conditioning <input type="checkbox"/> Stock <input type="checkbox"/> Lawn <input type="checkbox"/> Oil field water <input type="checkbox"/> Other
	9. Casing: Material <u>PRE</u> Height <u>Above</u> or below Threaded <input type="checkbox"/> Welded <input type="checkbox"/> Surface <u>18</u> in. RMP <input type="checkbox"/> PVC <input checked="" type="checkbox"/> Weight <u>2640</u> lbs./ft. Dia. <u>5</u> in. to <u>62</u> ft. depth Wall Thickness: inches or Dia. <u>5</u> in. to <u>62</u> ft. depth gage No. <u>2258</u>
	10. Screen: Manufacturer's name <u>Certain-Teed</u> Type <u>PRE</u> Dia. <u>5"</u> Slot/gauze <u>1/8</u> Length <u>15</u> Set between <u>45</u> ft. and <u>60</u> ft. _____ ft. and _____ ft. Gravel pack? <input checked="" type="checkbox"/> Size range of material <u>30</u>
	11. Static water level: _____ mo./day/yr. <u>40</u> ft. below land surface Date <u>7-1-76</u>
	12. Pumping level below land surfaces: _____ ft. after _____ hrs. pumping _____ g.p.m. _____ ft. after _____ hrs. pumping _____ g.p.m. Estimated maximum yield _____ g.p.m.
	13. Water sample submitted: _____ mo./day/yr. <input type="checkbox"/> Yes <input checked="" type="checkbox"/> No Date _____
	14. Well head completion: <input checked="" type="checkbox"/> Pitless adapter _____ Inches above grade
	15. Well grouted? <input checked="" type="checkbox"/> With: <input type="checkbox"/> Neat cement <input type="checkbox"/> Bentonite <input checked="" type="checkbox"/> Concrete Depth: From <u>3</u> ft. to <u>73</u> ft.
	16. Nearest source of possible contamination: <u>septic</u> ft. <u>60</u> Direction <u>N</u> Type <u>Tank</u> Well disinfected upon completion? <input checked="" type="checkbox"/> Yes <input type="checkbox"/> No
	17. Pump: <input checked="" type="checkbox"/> Not installed Manufacturer's name _____ Model number _____ HP _____ Volts _____ Length of drop pipe _____ ft. capacity _____ g.p.m. Type: <input type="checkbox"/> Submersible <input type="checkbox"/> Turbine <input type="checkbox"/> Jet <input type="checkbox"/> Reciprocating <input type="checkbox"/> Centrifugal <input type="checkbox"/> Other
(Use a second sheet if needed)	
18. Elevation: Topography: <input type="checkbox"/> Hill <input checked="" type="checkbox"/> Slope <input type="checkbox"/> Upland <input type="checkbox"/> Valley	19. Remarks:
20. Water well contractor's certification: This well was drilled under my jurisdiction and this report is true to the best of my knowledge and belief. <u>Boekhus Drgs 180</u> Business name _____ License No. _____ Address <u>Jampa, KS, 67403</u> Signed <u>Paul Boekhus</u> Date <u>7-6-76</u> Authorized representative	

19 - 30 W 28 Sec 1/4 1/4 1/4

Forward the white, blue and pink copies to the Department of Health and Environment

Form WWC-5