


1 LOCATION OF WATER WELL: Fraction Se 1/4 NW 1/4 Se 1/4 Section Number 16 Township Number T 19S Range Number R 4E  
 County: Marion

Distance and direction from nearest town or city street address of well if located within city?  
7 S 4 W Lincolnville

2 WATER WELL OWNER: Martin Klenda  
 RR#, St. Address, Box #: RR1  
 City, State, ZIP Code: Marion, Ke 66861  
 Board of Agriculture, Division of Water Resources  
 Application Number:

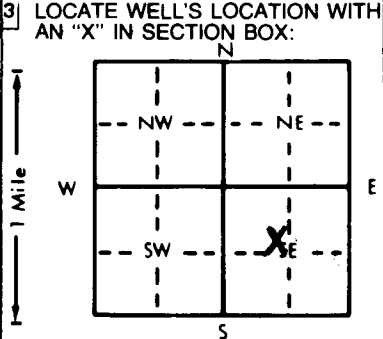

4 DEPTH OF COMPLETED WELL: 56 ft. ELEVATION: 43 ft.  
 Depth(s) Groundwater Encountered 1. 1 ft. 2. 27 ft. 3. 27-91 ft.  
 WELL'S STATIC WATER LEVEL: 27 ft. below land surface measured on mo/day/yr 6-27-91  
 Pump test data: Well water was 5 gpm Well water was 40 ft. after 7 hours pumping 56 gpm  
 Est. Yield 5 gpm Well water was 40 ft. after 7 hours pumping 56 gpm  
 Bore Hole Diameter: 8 1/2 in. to 40 ft., and 7 in. to 56 ft.  
 WELL WATER TO BE USED AS:  
 5 Public water supply 8 Air conditioning 11 Injection well  
 1 Domestic 3 Feedlot 6 Oil field water supply 9 Dewatering 12 Other (Specify below)  
 2 Irrigation 4 Industrial 7 Lawn and garden only 10 Monitoring well  
 Was a chemical/bacteriological sample submitted to Department? Yes.....No.....; If yes, mo/day/yr sample was submitted  
 Water Well Disinfected? Yes No

5 TYPE OF BLANK CASING USED:  
 1 Steel 3 RMP (SR) 5 Wrought iron 8 Concrete tile CASING JOINTS: Glued.....Clamped.....  
 2 PVC 4 ABS 6 Asbestos-Cement 9 Other (specify below) Welded.....  
 7 Fiberglass Threaded.....  
 Blank casing diameter 5 in. to 40 ft. Dia. 12 in. to 160 lbs./ft. Wall thickness or gauge No. 214  
 Casing height above land surface 12 in., weight 160 lbs./ft. Wall thickness or gauge No. 214  
 TYPE OF SCREEN OR PERFORATION MATERIAL:  
 1 Steel 3 Stainless steel 5 Fiberglass 7 PVC 10 Asbestos-cement  
 2 Brass 4 Galvanized steel 6 Concrete tile 8 RMP (SR) 11 Other (specify)  
 9 ABS 12 None used (open hole)  
 SCREEN OR PERFORATION OPENINGS ARE:  
 1 Continuous slot 3 Mill slot 5 Gauzed wrapped 8 Saw cut 11 None (open hole)  
 2 Louvered shutter 4 Key punched 6 Wire wrapped 9 Drilled holes  
 7 Torch cut 10 Other (specify)  
 SCREEN-PERFORATED INTERVALS: From 40 ft. to 56 ft. From ..... ft. to ..... ft.  
 GRAVEL PACK INTERVALS: From 20 ft. to 56 ft. From ..... ft. to ..... ft.

6 GROUT MATERIAL: 1 Neat cement 2 Cement grout 3 Bentonite 4 Other  
 Grout Intervals: From 0 ft. to 20 ft. From ..... ft. to ..... ft.  
 What is the nearest source of possible contamination:  
 1 Septic tank 4 Lateral lines 7 Pit privy 10 Livestock pens 14 Abandoned water well  
 2 Sewer lines 5 Cess pool 8 Sewage lagoon 11 Fuel storage 15 Oil well/Gas well  
 3 Watertight sewer lines 6 Seepage pit 9 Feedyard 12 Fertilizer storage 16 Other (specify below)  
 13 Insecticide storage  
 Direction from well? In Pasture for Cattle How many feet? None within 1/2 mi

FROM	TO	LITHOLOGIC LOG	FROM	TO	PLUGGING INTERVALS
0	30	Clay & loose lime Rock			
30	45	Gray Shale			
45	46	Water			
46	56	Gray Shale			

7 CONTRACTOR'S OR LANDOWNER'S CERTIFICATION: This water well was (1) constructed, (2) reconstructed or (3) plugged under my jurisdiction and was completed on (mo/day/year) 6-27-91 and this record is true to the best of my knowledge and belief. Kansas Water Well Contractor's License No. 180 This Water Well Record was completed on (mo/day/yr) 7-7-91 under the business name of Backhus Drilling by (signature) Paul H. Backhus

INSTRUCTIONS: Use typewriter or ball point pen. PLEASE PRESS FIRMLY and PRINT clearly. Please fill in blanks, underline or circle the correct answers. Send top three copies to Kansas Department of Health and Environment, Bureau of Water, Topeka, Kansas 66620-7320. Telephone: 913-296-5545. Send one to WATER WELL OWNER and retain one for your records.