

CORRECTION TO WATER WELL RECORD (WWC-5)

The following correction(s) was made to the attached WWC-5 log, in order to file the item or to rectify lacking or incorrect information.

Fraction ( 1/4 1/4 1/4) Section-Township-Range changed:

listed as SW SW NW, 25-195-3-4E

changed to SW SW NW, 25-195-4E

Other changes: Initial statements: \_\_\_\_\_

Changed to: \_\_\_\_\_

Comments: \_\_\_\_\_

verification method: written & legal descriptions, position on plat map, and

Marion & Lincolnville SW 1:24,000 topo. maps initials: RRD date: 2/25/2002  
(buildings shown on map)


submitted by: Kansas Geological Survey, Data Resources Library, 1930 Constant Ave., Lawrence, KS 66047-3726

to: Kansas Dept of Health & Environment Bureau of Water Industrial Programs, Bldg 283, Forbes Field, KS 66620

1 LOCATION OF WATER WELL: Fraction SW 1/4 SW 1/4 MW 1/4 Section Number 25 Township Number T 19 S Range Number R 3-4 E  
 County: Marion

Distance and direction from nearest town or city street address of well if located within city? 25  
3 E 1/2 N Marion

2 WATER WELL OWNER: Roland K. Parli  
 RR#, St. Address, Box #: RR 3 Box 106 Board of Agriculture, Division of Water Resources  
 City, State, ZIP Code: Marion, Ke. 66861 Application Number:

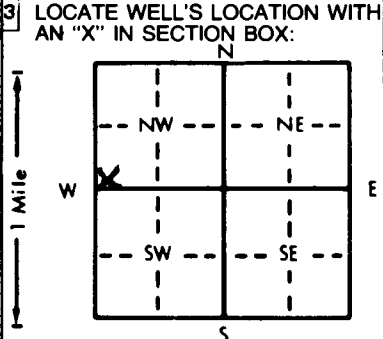

4 DEPTH OF COMPLETED WELL: 129 ft. ELEVATION: ..... ft.  
 Depth(s) Groundwater Encountered 1. 110 ft. 2. .... ft. 3. .... ft.  
 WELL'S STATIC WATER LEVEL 107 ft. below land surface measured on mo/day/yr 9-26-91  
 Pump test data: Well water was ..... ft. after ..... hours pumping ..... gpm  
 Est. Yield 15 gpm Well water was ..... ft. after ..... hours pumping ..... gpm  
 Bore Hole Diameter 2 1/2 in. to 129 ft., and ..... in. to ..... ft.  
 WELL WATER TO BE USED AS:  
 1 Domestic  3 Feedlot  6 Oil field water supply  9 Dewatering  12 Other (Specify below) .....  
 2 Irrigation  4 Industrial  7 Lawn and garden only  10 Monitoring well   
 Was a chemical/bacteriological sample submitted to Department? Yes.....No ; if yes, mo/day/yr sample was sub-  
 mitted Water Well Disinfected? Yes  No

5 TYPE OF BLANK CASING USED:  
 1 Steel  3 RMP (SR)  5 Wrought iron  8 Concrete tile  CASING JOINTS: Glued  Clamped .....  
 2 PVC  4 ABS  6 Asbestos-Cement  9 Other (specify below) ..... Welded .....  
 7 Fiberglass  Threaded .....  
 Blank casing diameter 5 in. to 9 1/2 in. Dia. .... in. to ..... ft. Dia. .... in. to ..... ft.  
 Casing height above land surface 12 in. weight CLASS 160 lbs./ft. Wall thickness or gauge No. 219  
 TYPE OF SCREEN OR PERFORATION MATERIAL:  
 1 Steel  3 Stainless steel  5 Fiberglass  7 PVC  10 Asbestos-cement   
 2 Brass  4 Galvanized steel  6 Concrete tile  8 RMP (SR)  11 Other (specify) .....  
 12 None used (open hole) .....  
 SCREEN OR PERFORATION OPENINGS ARE:  
 1 Continuous slot  3 Mill slot  5 Gauzed wrapped  8 Saw cut  11 None (open hole) .....  
 2 Louvered shutter  4 Key punched  6 Wire wrapped  9 Drilled holes   
 7 Torch cut  10 Other (specify) .....  
 SCREEN-PERFORATED INTERVALS: From 98 ft. to 129 ft., From ..... ft. to ..... ft.  
 From ..... ft. to ..... ft., From ..... ft. to ..... ft.  
 GRAVEL PACK INTERVALS: From 24 ft. to 129 ft., From ..... ft. to ..... ft.  
 From ..... ft. to ..... ft., From ..... ft. to ..... ft.

6 GROUT MATERIAL: 4 Neat cement 24 Cement grout 3 Bentonite 4 Other .....  
 Grout Intervals: From 4 ft. to 24 ft., From ..... ft. to ..... ft., From ..... ft. to ..... ft.  
 What is the nearest source of possible contamination:  
 1 Septic tank  4 Lateral lines  7 Pit privy  10 Livestock pens  14 Abandoned water well   
 2 Sewer lines  5 Cess pool  8 Sewage lagoon  11 Fuel storage  15 Oil well/Gas well   
 3 Watertight sewer lines  6 Seepage pit  9 Feedyard  12 Fertilizer storage  16 Other (specify below) .....  
 13 Insecticide storage   
 Direction from well? SW How many feet? 150 +

FROM	TO	LITHOLOGIC LOG	FROM	TO	PLUGGING INTERVALS
0	10	Clay			
10	45	yellow shale & mixed lime			
45	60	Blue shale			
60	72	Red			
72	110	yellow shale, mixed lime			
110	111	Water			
111	120	yellow shale			
120	129	Red shale			

7 CONTRACTOR'S OR LANDOWNER'S CERTIFICATION: This water well was (1) constructed (2) reconstructed, or (3) plugged under my jurisdiction and was completed on (mo/day/year) 9-26-91 and this record is true to the best of my knowledge and belief. Kansas Water Well Contractor's License No. 120 This Water Well Record was completed on (mo/day/yr) 10-1-91 under the business name of Backhus Drilling by (signature) Paul H. Backhus