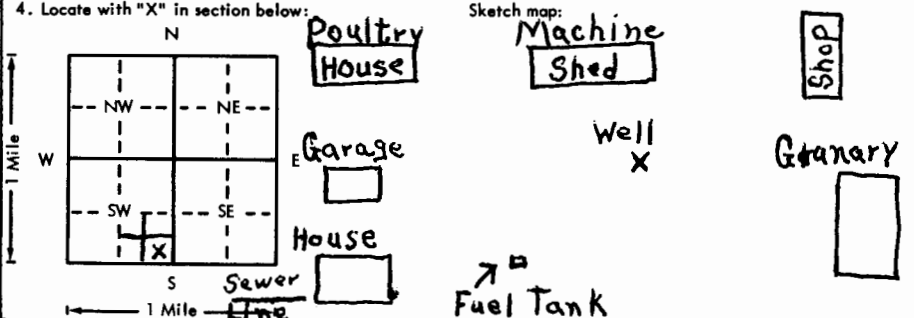


USE TYPEWRITER OR BALL POINT PEN—PRESS FIRMLY, PRINT CLEARLY.

WATER WELL RECORD
KSA 82a-1201-1215

Kansas Department of Health and Environment—Division of Environment
(Water well Contractors)
Topeka, Kansas 66620

| | | | | | | | | | |
|---|--|--|--|---|--|--------------------------------------|--|--------------------------|--|
| 1. Location of well: County: Marion | | Fraction: SE 1/4 SE 1/4 SW 1/4 | | Section number: 5 | | Township number: T 19 S R 4 E | | Range number: 4 E | |
| 2. Distance and direction from nearest town or city: 5 mi North of Marion, Kans. Street address of well location if in city: | | | | 3. Owner of well: George Oborny R.R. or street: Route 3 City, state, zip code: Marion, Kans. 66861 | | | | | |
| 4. Locate with "X" in section below:  | | | | 6. Bore hole dia. 7.5 in. Completion date: 12-2-77 Well depth 76 ft. | | | | | |
| | | | | 7. <input checked="" type="checkbox"/> Cable tool <input type="checkbox"/> Rotary <input type="checkbox"/> Driven <input type="checkbox"/> Dug <input type="checkbox"/> Hollow rod <input type="checkbox"/> Jetted <input type="checkbox"/> Bored <input type="checkbox"/> Reverse rotary | | | | | |
| | | | | 8. Use: <input type="checkbox"/> Domestic <input type="checkbox"/> Public supply <input type="checkbox"/> Industry <input type="checkbox"/> Irrigation <input type="checkbox"/> Air conditioning <input checked="" type="checkbox"/> Stock <input type="checkbox"/> Lawn <input type="checkbox"/> Oil field water <input type="checkbox"/> Other | | | | | |
| | | | | 9. Casing: Material Plastic Height: Above or below Threaded <input type="checkbox"/> Welded <input checked="" type="checkbox"/> Surface 14 in. RMP <input type="checkbox"/> PVC <input checked="" type="checkbox"/> Weight 3 lbs./ft. Dia. 6 in. to 46 ft. depth Wall Thickness 3/16 inches or Dia. <input type="checkbox"/> in. to <input type="checkbox"/> ft. depth gage No. 32-17 | | | | | |
| 5. Type and color of material | | | | From | | To | | | |
| Good Black Soil | | | | 0 | | 2 | | | |
| Clay Brown | | | | 2 | | 10 | | | |
| Clay Light yellow | | | | 10 | | 29 | | | |
| Clay Dark Red | | | | 29 | | 38 | | | |
| Clay Gray to white | | | | 38 | | 43 | | | |
| Blue Shale Dark | | | | 43 | | 54 | | | |
| Sand Med. Blue + yellow | | | | 54 | | 59 | | | |
| Sand Med. Yellow + white | | | | 59 | | 65 | | | |
| Blue Shale Med. | | | | 65 | | 73 | | | |
| Clay Med. Red | | | | 73 | | 76 | | | |
| Screen is made from solid plastic casing by boring 3/8 in. Dia. holes neatly in order at average of 18 holes per. ft. | | | | | | | | | |
| (Use a second sheet if needed) | | | | | | | | | |
| 18. Elevation: | | 19. Remarks: The pump installation was completed by the owner. | | | | | | | |
| Topography: <input type="checkbox"/> Hill <input type="checkbox"/> Slope <input checked="" type="checkbox"/> Upland <input type="checkbox"/> Valley | | 20. Water well contractor's certification: This well was drilled under my jurisdiction and this report is true to the best of my knowledge and belief. Benda Drilling 161 Business name License No. Address Lincolntonville, KS 66858 Signed Paul W. Benda Date 12-17-77 Authorized representative | | | | | | | |

T 19
R 4
W 17
S 5
