


1 LOCATION OF WATER WELL: Fraction SW 1/4 SW 1/4 SW 1/4 Section Number 32 Township Number T 19 S Range Number R 24 E
 County: Marion

Distance and direction from nearest town or city street address of well if located within city?
In City Marion 315 S Lincoln

2 WATER WELL OWNER: J.D. Miller
 RR#, St. Address, Box #: 315 S Lincoln Board of Agriculture, Division of Water Resources
 City, State, ZIP Code: Marion, KY 66861 Application Number:

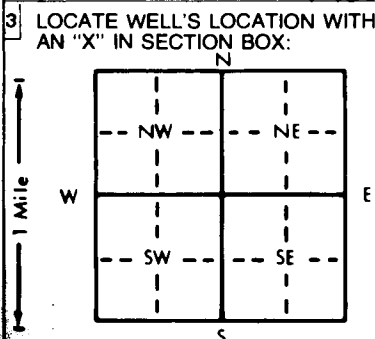

4 DEPTH OF COMPLETED WELL: 95 ft. ELEVATION:
 Depth(s) Groundwater Encountered 1. 8.5 ft. 2. ft. 3. ft.
 WELL'S STATIC WATER LEVEL: 42 ft. below land surface measured on mo/day/yr 9-9-97
 Pump test data: Well water was ft. after hours pumping gpm
 Est. Yield 20 gpm Well water was ft. after hours pumping gpm
 Bore Hole Diameter: 9 in. to 20 ft., and 7 1/2 in. to 95 ft.
 WELL WATER TO BE USED AS:
 5 Public water supply 8 Air conditioning 11 Injection well
 1 Domestic 3 Feedlot 6 Oil field water supply 9 Dewatering 12 Other (Specify below)
 2 Irrigation 4 Industrial 7 Lawn and garden only 10 Monitoring well
 Was a chemical/bacteriological sample submitted to Department? Yes..... No X; If yes, mo/day/yr sample was submitted
 Water Well Disinfected? Yes X No

5 TYPE OF BLANK CASING USED:
 1 Steel 3 RMP (SR) 5 Wrought iron 8 Concrete tile CASING JOINTS: Glued X Clamped
 2 PVC 4 ABS 6 Asbestos-Cement 9 Other (specify below) Welded
 7 Fiberglass Threaded

Blank casing diameter: 5 in. to 7 1/2 ft. Dia. in. to ft. Dia. in. to ft.
 Casing height above land surface: 12 in., weight Class 160 lbs./ft. Wall thickness or gauge No. 2/4

TYPE OF SCREEN OR PERFORATION MATERIAL:
 1 Steel 3 Stainless steel 5 Fiberglass 7 PVC 10 Asbestos-cement
 2 Brass 4 Galvanized steel 6 Concrete tile 8 RMP (SR) 11 Other (specify)
 9 ABS 12 None used (open hole)

SCREEN OR PERFORATION OPENINGS ARE:
 1 Continuous slot 3 Mill slot 5 Gauzed wrapped 8 Saw cut 11 None (open hole)
 2 Louvered shutter 4 Key punched 6 Wire wrapped 9 Drilled holes
 7 Torch cut 10 Other (specify)

SCREEN-PERFORATED INTERVALS: From 75 ft. to 95 ft., From ft. to ft.
 From ft. to ft., From ft. to ft.
 GRAVEL PACK INTERVALS: From ft. to ft., From ft. to ft.
 From ft. to ft., From ft. to ft.

6 GROUT MATERIAL: 1 Neat cement 2 Cement grout 3 Bentonite 4 Other
 Grout Intervals: From 0 ft. to 20 ft., From ft. to ft., From ft. to ft.

What is the nearest source of possible contamination:
 1 Septic tank 4 Lateral lines 7 Pit privy 10 Livestock pens 14 Abandoned water well
 2 Sewer lines 5 Cess pool 8 Sewage lagoon 11 Fuel storage 15 Oil well/Gas well
 3 Watertight sewer lines 6 Seepage pit 9 Feedyard 12 Fertilizer storage 16 Other (specify below)
 13 Insecticide storage
 Direction from well? E How many feet? 40'

FROM	TO	LITHOLOGIC LOG	FROM	TO	PLUGGING INTERVALS
0	6	Clay			
6	41	limestone			
41	55	Yellow Shale			
55	70	Lime			
70	80	Red Shale			
80	85	Lime			
85		Water			
86	95	Gray Rock Hard			

7 CONTRACTOR'S OR LANDOWNER'S CERTIFICATION: This water well was (1) constructed, (2) reconstructed, or (3) plugged under my jurisdiction and was completed on (mo/day/year) 9-9-97 and this record is true to the best of my knowledge and belief. Kansas
 Water Well Contractor's License No. 180 This Water Well Record was completed on (mo/day/yr) 9-9-97
 under the business name of Backhus Drilling by (signature) Paul H. Backhus

INSTRUCTIONS: Use typewriter or ball point pen. PLEASE PRESS FIRMLY and PRINT clearly. Please fill in blanks, underline or circle the correct answers. Send top three copies to Kansas Department of Health and Environment, Bureau of Water, Topeka, Kansas 66620-0001. Telephone: 913-296-5545. Send one to WATER WELL OWNER and retain one for your records.

OFFICE USE ONLY
T
R
EM
SEC.
1/4
1/4
1/4