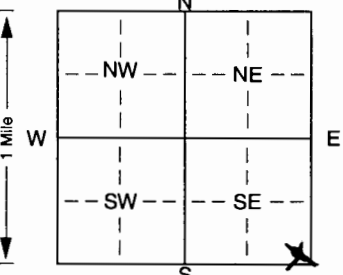


1 LOCATION OF WATER WELL: Fraction SE 1/4 SE 1/4 SE 1/4 Section Number 28 Township Number T 19 S Range Number R 5 E  
 County: Marion

Distance and direction from nearest town or city street address of well if located within city?

**7 miles East of Marion, KS**

2 WATER WELL OWNER: Wittwer Paving  
 RR#, St. Address, Box #: 3919 S. West Street Board of Agriculture, Division of Water Resources  
 City, State, ZIP Code: Wichita, KS 67217 Application Number:

3 LOCATE WELL'S LOCATION WITH AN "X" IN SECTION BOX:  
  
 4 DEPTH OF COMPLETED WELL: 120 ft. ELEVATION:  
 Depth(s) Groundwater Encountered 1. . . . . ft. 2. . . . . ft. 3. . . . . ft.  
 WELL'S STATIC WATER LEVEL 15 ft. below land surface measured on mo/day/yr 3/8/02  
 Pump test data: Well water was 60 ft. after 2 hours pumping 50 gpm  
 Est. Yield 80 gpm: Well water was . . . . . ft. after . . . . . hours pumping . . . . . gpm  
 Bore Hole Diameter: 9 in. to 120 ft., and . . . . . in. to . . . . . ft.  
 WELL WATER TO BE USED AS: 5 Public water supply 8 Air conditioning 11 Injection well  
 1 Domestic 3 Feedlot 6 Oil field water supply 9 Dewatering  Other (Specify below)  
 2 Irrigation 4 Industrial 7 Domestic (lawn & garden) 10 Monitoring well . . . . . Supply well for  
 Was a chemical/bacteriological sample submitted to Department? Yes. . . . . No.  ; If yes, mo/day/yr sample was sub-  
 mitted Water Well Disinfected? Yes  No

5 TYPE OF BLANK CASING USED: 5 Wrought iron 8 Concrete tile CASING JOINTS: Glued  Clamped . . . . .  
 1 Steel 3 RMP (SR) 6 Asbestos-Cement 9 Other (specify below) Welded . . . . .  
 PVC 4 ABS 7 Fiberglass . . . . . Threaded . . . . .  
 Blank casing diameter 5 in. to 40 ft., Dia . . . . . in. to . . . . . ft., Dia . . . . . in. to . . . . . ft.  
 Casing height above land surface: 12 in., weight 2.37 lbs./ft. Wall thickness or gauge No. 214  
 TYPE OF SCREEN OR PERFORATION MATERIAL:  PVC 10 Asbestos-cement  
 1 Steel 3 Stainless steel 5 Fiberglass 8 RMP (SR) 11 Other (specify) . . . . .  
 2 Brass 4 Galvanized steel 6 Concrete tile 9 ABS 12 None used (open hole)  
 SCREEN OR PERFORATION OPENINGS ARE: 5 Gauzed wrapped 8 Saw cut 11 None (open hole)  
 1 Continuous slot  Mill slot 6 Wire wrapped 9 Drilled holes  
 2 Louvered shutter 4 Key punched 7 Torch cut 10 Other (specify) . . . . . ft.  
 SCREEN-PERFORATED INTERVALS: From 40 ft. to 120 ft., From . . . . . ft. to . . . . . ft.  
 From . . . . . ft. to . . . . . ft., From . . . . . ft. to . . . . . ft.  
 GRAVEL PACK INTERVALS: From 22 ft. to 120 ft., From . . . . . ft. to . . . . . ft.  
 From . . . . . ft. to . . . . . ft., From . . . . . ft. to . . . . . ft.

6 GROUT MATERIAL: 1 Neat cement 2 Cement grout  Bentonite 4 Other . . . . .  
 Grout Intervals: From 0 ft. to 22 ft., From . . . . . ft. to . . . . . ft., From . . . . . ft. to . . . . . ft.  
 What is the nearest source of possible contamination: None within 1/4 mile 10 Livestock pens 14 Abandoned water well  
 1 Septic tank 4 Lateral lines 7 Pit privy 11 Fuel storage 15 Oil well/Gas well  
 2 Sewer lines 5 Cess pool 8 Sewage lagoon 12 Fertilizer storage 16 Other (specify below)  
 3 Watertight sewer lines 6 Seepage pit 9 Feedyard 13 Insecticide storage . . . . .  
 Direction from well? How many feet?

FROM	TO	LITHOLOGIC LOG	FROM	TO	PLUGGING INTERVALS
0	2	Topsoil			
2	16	Shale			
16	42	Limestone			
42	48	Flint rock			
48	92	Limestone with flint rock and shale layers			
92	95	Fractured limestone			
95	120	Limestone			

7 CONTRACTOR'S OR LANDOWNER'S CERTIFICATION: This water well was ( constructed, (2) reconstructed, or (3) plugged under my jurisdiction and was completed on (mo/day/year) 3/11/02 and this record is true to the best of my knowledge and belief. Kansas Water Well Contractor's Licence No. 138. This Water Well Record was completed on (mo/day/yr) 3/18/02 under the business name of Peterson Irrigation, Inc. by (signature) Mike Peters