


1	LOCATION OF WATER WELL: County: <u>Chase</u>	Fraction <u>NW</u> <u>SE</u> <u>NE</u> <u>1/4</u> <u>1/4</u> <u>1/4</u>	Section Number <u>24</u>	Township Number <u>19</u>	Range Number <u>7E</u>
---	---	---	-----------------------------	------------------------------	---------------------------

Distance and direction from nearest town or city street address of well if located within city?  
2 West 1/2 South Strong City

2 WATER WELL OWNER: Ken Clark  
RR#, St. Address, Box #: 1686 Timothy. Board of Agriculture, Division of Water Resources  
City, State, ZIP Code: Wichita KS 67212 Application Number:

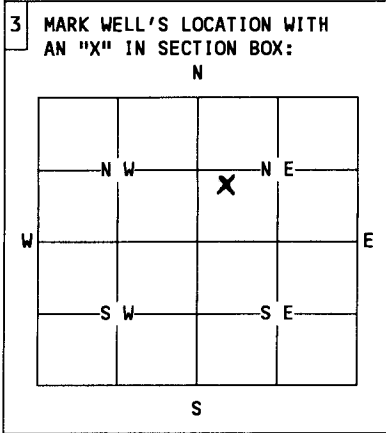

4 DEPTH OF WELL.....30'.....ft.  
WELL'S STATIC WATER LEVEL...22'.....ft.  
WELL WAS USED AS:  
1 Domestic 5 Public Water Supply 9 Dewatering  
2 Irrigation 6 Oil Field Water Supply 10 Monitoring Well  
 Feedlot 7 Lawn and Garden Only 11 Injection Well  
4 Industrial 8 Air Conditioning 12 Other.....  
Was a chemical/bacteriological sample submitted to Department? Yes....No.  
If yes, mo/day/yr sample was submitted.....  
Water Well Disinfected: Yes. No.....

5 TYPE OF BLANK CASING USED:  
 Steel 3 RMP (SR) 5 Wrought 7 Fiberglass 9 Other (specify below)  
2 PVC 4 ABS 6 Asbestos-Cement 8 Concrete Tile  
Blank casing diameter.....6 1/2 in. Was casing pulled? Yes... No..... If yes, how much...9'  
Casing height above or below land surface.....7' Below

6 GROUT PLUG MATERIAL: 1 Neat cement 2 Cement grout  Bentonite 4 Other.....  
Grout Plug Intervals: From..7..ft. to..22..ft., From.....ft. to.....ft., From..... to.....ft.  
What is the nearest source of possible contamination:  
1 Septic tank 6 Seepage pit 11 Fuel storage 16 Other (specify below)  
2 Sewer lines 7 Pit privy 12 Fertilizer storage  
3 Watertight sewer lines 8 Sewage lagoon 13 Insecticide storage  
4 Lateral lines 9 Feedyard 14 Abandoned water well  
5 Cess Pool 10 Livestock pens 15 Oil well/Gas well  
Direction from well? ....Abandoned pens, How many feet? ....20'

FROM	TO	PLUGGING MATERIALS
<u>7</u>	<u>22</u>	<u>Bentonite</u>
<u>22</u>	<u>30</u>	<u>Pack Gravel</u>

well No 2. Barn Lot Disinfect 3gal Bleach. Fill to 22' with Pack Gravel Filled to 7' with Bentonite Dug out to 7' pulled casing ~~Apert~~ Placed Bentonite over Casing & 4' Acra. Ground Casing. Filled To Surface

7 CONTRACTOR'S OR LANDOWNER'S CERTIFICATION: This water well was plugged under my jurisdiction and was completed on (mo/day/year)..11-14-95... and this record is true to the best of my knowledge and belief. Kansas Water Well Contractor's License No. 203..... This Water Well Record was completed on (mo/day/year) ..11-27-95... under the business name of McNee Drilling & Metals..... by (signature) ..[Signature].....

INSTRUCTIONS: Use typewriter or ball point pen. Please press firmly and print clearly. Please fill in blanks, underline or circle the correct answers. Send top three copies to Kansas Department of Health and Environment, Bureau of Water, Topeka, Kansas 66620-0001. Telephone: 913/296-3565. Send one to Water Well Owner and retain one for your records.