


1 LOCATION OF WATER WELL: County: Chase Fraction: SE 1/4 NW 1/4 SW 1/4 Section Number: 22 Township Number: T 19 S Range Number: R 7 EW

Distance and direction from nearest town or city street address of well if located within city?
1/2 mile North of Elmdale

2 WATER WELL OWNER: Galen Simmons
RR#, St. Address, Box #: Rt 1 Box 5
City, State, ZIP Code: Elmdale, Kan. 66850
Board of Agriculture, Division of Water Resources
Application Number:

3 LOCATE WELL'S LOCATION WITH AN "X" IN SECTION BOX:

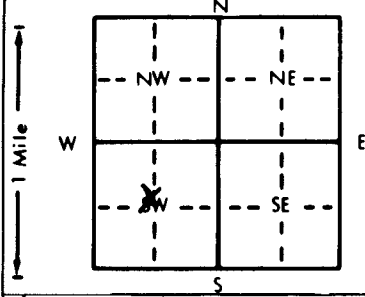

4 DEPTH OF COMPLETED WELL: 50 ft. ELEVATION:
Depth(s) Groundwater Encountered 1. 30 ft. 2. _____ ft. 3. _____ ft.

WELL'S STATIC WATER LEVEL: 20 ft. below land surface measured on mo/day/yr Apr 18-98
Pump test data: Well water was _____ ft. after _____ hours pumping _____ gpm
Est. Yield: 13 gpm; Well water was _____ ft. after _____ hours pumping _____ gpm
Bore Hole Diameter: 8 5/8 in. to 43 ft. and 7 in. to 50 ft.
WELL WATER TO BE USED AS:
1 Domestic 3 Feedlot 6 Oil field water supply 9 Dewatering 12 Other (Specify below)
2 Irrigation 4 Industrial 7 Lawn and garden only 10 Monitoring well
Was a chemical/bacteriological sample submitted to Department? Yes _____ No X; If yes, mo/day/yr sample was submitted
Water Well Disinfected Yes No

5 TYPE OF BLANK CASING USED:
1 Steel 3 RMP (SR) 5 Wrought iron 8 Concrete tile CASING JOINTS: Glued X Clamped _____
2 PVC 4 ABS 6 Asbestos-Cement 9 Other (specify below) Welded _____
Blank casing diameter: 5 in. to 30 ft. Dia _____ in. to _____ ft. Dia _____ in. to _____ ft.
Casing height above land surface: 48 in., weight _____ lbs./ft. Wall thickness or gauge No. SDH-26
TYPE OF SCREEN OR PERFORATION MATERIAL:
1 Steel 3 Stainless steel 5 Fiberglass 8 RMP (SR) 10 Asbestos-cement
2 Brass 4 Galvanized steel 6 Concrete tile 9 ABS 11 Other (specify) _____
SCREEN OR PERFORATION OPENINGS ARE:
1 Continuous slot 3 Mill slot 5 Gauzed wrapped 8 Saw cut 11 None (open hole)
2 Louvered shutter 4 Key punched 6 Wire wrapped 9 Drilled holes
7 Torch cut 10 Other (specify) _____

SCREEN-PERFORATED INTERVALS: From 30 ft. to 50 ft., From _____ ft. to _____ ft.
GRAVEL PACK INTERVALS: From 24 ft. to 50 ft., From _____ ft. to _____ ft.

6 GROUT MATERIAL: 1 Neat cement 2 Cement grout 3 Bentonite 4 Other _____
Grout Intervals: From 3 ft. to 24 ft., From _____ ft. to _____ ft., From _____ ft. to _____ ft.
What is the nearest source of possible contamination:
1 Septic tank 4 Lateral lines 7 Pit privy 10 Livestock pens 14 Abandoned water well
2 Sewer lines 5 Cess pool 8 Sewage lagoon 11 Fuel storage 15 Oil well/Gas well
3 Watertight sewer lines 6 Seepage pit 9 Feedyard 12 Fertilizer storage 16 Other (specify below)
Direction from well? South West 13 Insecticide storage Creek
How many feet? 400

FROM	TO	LITHOLOGIC LOG	FROM	TO	PLUGGING INTERVALS
0	5	Top Soil			
5	20	Clay Red			
20	33	Silt			
33	38	Gravel			
38	42	Shale Gray			
42	45	LIME TAN			
45	50	Shale Red			

7 CONTRACTOR'S OR LANDOWNER'S CERTIFICATION: This water well was (1) constructed, (2) reconstructed, or (3) plugged under my jurisdiction and was completed on (mo/day/year) Apr 18-98 and this record is true to the best of my knowledge and belief. Kansas Water Well Contractor's License No. 218 This Water Well Record was completed on (mo/day/yr) Apr 27-98 under the business name of ZINN Water Well Dring by (signature) Joseph A. Zinn

OFFICE USE ONLY T R EW SEC. 1/4 1/4 1/4