


1 LOCATION OF WATER WELL: Fraction NW 1/4 SE 1/4 SE 1/4 Section Number 12 Township Number T 19 S Range Number R 7 E  
 County: Chase

Distance and direction from nearest town or city street address of well if located within city?  
1 East 3/4 North Neva.

2 WATER WELL OWNER: Bill Short  
 RR#, St. Address, Box #: RR-1 Board of Agriculture, Division of Water Resources  
 City, State, ZIP Code: Strong City Ks. 66869 Application Number: NA

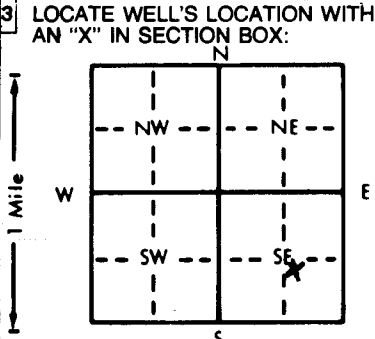

4 DEPTH OF COMPLETED WELL: 127 ft. ELEVATION:  
 Depth(s) Groundwater Encountered 1. 60 ft. 2. 122 ft. 3. .... ft.  
 WELL'S STATIC WATER LEVEL: 71 ft. below land surface measured on mo/day/yr 11-17-88  
 Pump test data: Well water was ..... ft. after ..... hours pumping ..... gpm  
 Est. Yield 15 gpm: Well water was ..... ft. after ..... hours pumping ..... gpm  
 Bore Hole Diameter: 8 in. to 127 ft., and ..... in. to ..... ft.  
 WELL WATER TO BE USED AS:  
 Domestic     Feedlot     Oil field water supply     Dewatering     12 Other (Specify below)  
 2 Irrigation     4 Industrial     7 Lawn and garden only     10 Monitoring well  
 Was a chemical/bacteriological sample submitted to Department? Yes.....No..... If yes, mo/day/yr sample was submitted  
 Water Well Disinfected? Yes  No

5 TYPE OF BLANK CASING USED:  
 1 Steel     3 RMP (SR)     6 Asbestos-Cement     9 Other (specify below)     Welded  
 2 PVC     4 ABS     7 Fiberglass    .....     Threaded  
 Blank casing diameter: 5 1/2 in. to 87 ft., Dia ..... in. to ..... ft., Dia ..... in. to ..... ft.  
 Casing height above land surface: 18 in., weight ..... lbs./ft. Wall thickness or gauge No. 160  
 TYPE OF SCREEN OR PERFORATION MATERIAL:  
 1 Steel     3 Stainless steel     5 Fiberglass     8 RMP (SR)     11 Other (specify) .....  
 2 Brass     4 Galvanized steel     6 Concrete tile     9 ABS     12 None used (open hole)  
 SCREEN OR PERFORATION OPENINGS ARE:  
 1 Continuous slot     3 Mill slot     6 Wire wrapped     9 Drilled holes  
 2 Louvered shutter     4 Key punched     7 Torch cut     10 Other (specify) .....  
 SCREEN-PERFORATED INTERVALS: From 87 ft. to 127 ft., From ..... ft. to ..... ft.  
 GRAVEL PACK INTERVALS: From ..... ft. to ..... ft., From ..... ft. to ..... ft.

6 GROUT MATERIAL:  1 Neat cement     2 Cement grout     3 Bentonite     4 Other .....  
 Grout intervals: From 4 ft. to 16 ft., From ..... ft. to ..... ft., From ..... ft. to ..... ft.  
 What is the nearest source of possible contamination:  
 1 Septic tank     4 Lateral lines     7 Pit privy     10 Livestock pens     14 Abandoned water well  
 2 Sewer lines     5 Cess pool     8 Sewage lagoon     11 Fuel storage     15 Oil well/Gas well  
 3 Watertight sewer lines     6 Seepage pit     9 Feedyard     12 Fertilizer storage     16 Other (specify below)  
 13 Insecticide storage  
 Direction from well? South East Down Grade How many feet? 300

FROM	TO	LITHOLOGIC LOG	FROM	TO	PLUGGING INTERVALS
0	1	TS.	117	124	Gray Lime H2O 150 ppm.
1	4	CL	124	127	SH. Gray.
4	8	LS white			
8	23	Broken Lime + shale			Nitrate 15
23	23.5	Hard Lime			Sulfate 65
25	30	SH Red + Green.			Chloride 104
30	47	SH Venigated Boxwork.			Field Tests
47	48	Dense Lime			water Shows Carbonation.
48	54	Broken Lime + shale took Fluid			
54	58	Lime Cotton wood.			
58	60.3	Broken Lim + shale 1/4 gpm			Shale Catcher.
63	112	Eskridge shale			110'
112	114	Lime Brown med Dense			
114	117	Gray shaley Lime			

7 CONTRACTOR'S OR LANDOWNER'S CERTIFICATION: This water well was  constructed,  reconstructed, or  plugged under my jurisdiction and was completed on (mo/day/year) 11-17-88 and this record is true to the best of my knowledge and belief. Kansas Water Well Contractor's License No. 203 This Water Well Record was completed on (mo/day/yr) 11-18-88 under the business name of McNee Drilling + metals. by (signature) J. C. Mone

INSTRUCTIONS: Use typewriter or ball point pen. PLEASE PRESS FIRMLY and PRINT clearly. Please fill in blanks, underline or circle the correct answers. Send top three copies to Kansas Department of Health and Environment, Bureau of Water Protection, Topeka, Kansas 66620-7320. Telephone: 913-296-5514. Send one to WATER WELL OWNER and retain one for your records.

OFFICE USE ONLY  
T  
R  
EW  
SEC.  
1/4  
1/4  
1/4