


1 LOCATION OF WATER WELL: County: Chase Fraction: NW SW 1/4 NE 1/4 SE 1/4 Section Number: 21 Township Number: T 19 S Range Number: 7 R NE (EW)

Distance and direction from nearest town or city street address of well if located within city? 3/4 W of 1/2 N of Elmdale

2 WATER WELL OWNER: Larry Cohn
 RR#, St. Address, Box #: Rt 1
 City, State, ZIP Code: Elmdale Ks 66850
 Board of Agriculture, Division of Water Resources
 Application Number:

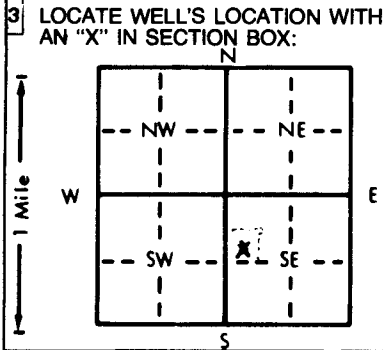

4 DEPTH OF COMPLETED WELL: 40 ft. ELEVATION: _____
 Depth(s) Groundwater Encountered 1. 24 ft. 2. _____ ft. 3. _____ ft.
 WELL'S STATIC WATER LEVEL: 18 ft. below land surface measured on mo/day/yr Nov 12 86
 Pump test data: Well water was _____ ft. after _____ hours pumping _____ gpm
 Est. Yield: 12 gpm: Well water was _____ ft. after _____ hours pumping _____ gpm
 Bore Hole Diameter: 8 in. to 3 1/4 in. and 6 1/4 in. to 40 in.
 WELL WATER TO BE USED AS:
 Domestic 3 Feedlot 6 Oil field water supply 9 Dewatering 12 Other (Specify below)
 2 Irrigation 4 Industrial 7 Lawn and garden only 10 Observation well
 Was a chemical/bacteriological sample submitted to Department? Yes _____ No If yes, mo/day/yr sample was submitted _____
 Water Well Disinfected? Yes No

5 TYPE OF BLANK CASING USED:
 1 Steel 3 RMP (SR) 5 Wrought iron 8 Concrete tile CASING JOINTS: Glued Clamped _____
 2 Brass 4 Galvanized steel 6 Asbestos-Cement 9 Other (specify below) Welded _____
 3 PVC 4 ABS 7 Fiberglass Threaded _____
 Blank casing diameter: 5 in. to 18 in. Dia. 5 in. to _____ in. Dia. _____ in. to _____ in.
 Casing height above land surface: 48 in., weight _____ lbs./ft. Wall thickness or gauge No. SPR 26
 TYPE OF SCREEN OR PERFORATION MATERIAL:
 1 Steel 3 Stainless steel 5 Fiberglass 7 RMP (SR) 10 Asbestos-cement
 2 Brass 4 Galvanized steel 6 Concrete tile 9 ABS 11 Other (specify) _____
 12 None used (open hole)
 SCREEN OR PERFORATION OPENINGS ARE:
 1 Continuous slot 3 Mill slot 5 Gauzed wrapped 7 Saw cut 11 None (open hole)
 2 Louvered shutter 4 Key punched 6 Wire wrapped 9 Drilled holes
 7 Torch cut 10 Other (specify) _____
 SCREEN-PERFORATED INTERVALS: From 18 ft. to 40 ft. From _____ ft. to _____ ft.
 From _____ ft. to _____ ft. From _____ ft. to _____ ft.
 GRAVEL PACK INTERVALS: From 13 ft. to 40 ft. From _____ ft. to _____ ft.
 From _____ ft. to _____ ft. From _____ ft. to _____ ft.

6 GROUT MATERIAL: 1 Neat cement 2 Cement grout 3 Bentonite 4 Other _____
 Grout Intervals: From 3 ft. to 13 ft. From _____ ft. to _____ ft. From _____ ft. to _____ ft.
 What is the nearest source of possible contamination:
 1 Septic tank 4 Lateral lines 7 Pit privy 10 Livestock pens 14 Abandoned water well
 2 Sewer lines 5 Cess pool 8 Sewage lagoon 11 Fuel storage 15 Oil well/Gas well
 3 Watertight sewer lines 6 Seepage pit 9 Feedyard 12 Fertilizer storage 16 Other (specify below)
 13 Insecticide storage Creek
 Direction from well? North How many feet? 1000

FROM	TO	LITHOLOGIC LOG	FROM	TO	LITHOLOGIC LOG
<u>0</u>	<u>9</u>	<u>Black Soil</u>			
<u>9</u>	<u>17</u>	<u>Gray silt</u>			
<u>17</u>	<u>24</u>	<u>Silt Brn</u>			
<u>24</u>	<u>31</u>	<u>Gravel</u>			
<u>31</u>	<u>34</u>	<u>Shale Blue Green</u>			
<u>34</u>	<u>37</u>	<u>Lime lite</u>			
<u>37</u>	<u>40</u>	<u>Shale Gray</u>			

7 CONTRACTOR'S OR LANDOWNER'S CERTIFICATION: This water well was (1) constructed, (2) reconstructed, or (3) plugged under my jurisdiction and was completed on (mo/day/year) Nov 12 86 and this record is true to the best of my knowledge and belief. Kansas Water Well Contractor's License No. 218 This Water Well Record was completed on (mo/day/yr) Dec 8 86 under the business name of Zinn Water Well Dring by (signature) Joseph A Zinn
 INSTRUCTIONS: Use typewriter or ball point pen, PLEASE PRESS FIRMLY and PRINT clearly. Please fill in blanks, underline or circle the correct answers. Send top three copies to Kansas Department of Health and Environment, Division of Environment, Environmental Geology Section, Topeka, KS 66620. Send one to WATER WELL OWNER and retain one for your records.

OFFICE USE ONLY