


1	LOCATION OF WATER WELL:	Fraction	Section Number	Township Number	Range Number
County:	CHASE	NW 1/4 NW 1/4 SW 1/4	20	19	8E

Distance and direction from nearest town or city street address of well if located within city? 1 mi West + 1/2 mile North of Cottonwood Falls

2 WATER WELL OWNER: City of Cottonwood Falls
 RR #, St. Address, Box #: Box 487
 City, State, ZIP Code: Cottonwood Falls, KS 66845
 Board of Agriculture, Division of Water Resources
 Application Number: _____

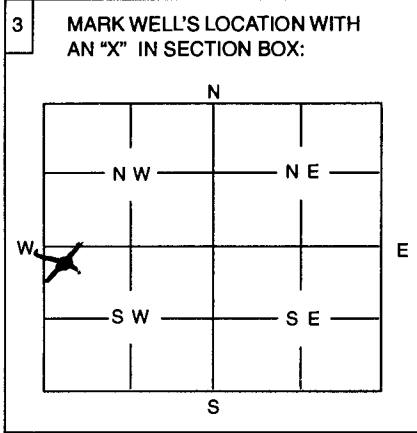

4 DEPTH OF WELL 42 ft
 WELL'S STATIC WATER LEVEL 9 ft.
 WELL WAS USED AS:
 1 Domestic 5 Public Water Supply 9 Dewatering
 2 Irrigation 6 Oil Field Water Supply 10 Monitoring Well
 3 Feedlot 7 Domestic (Lawn & Garden) 11 Injection Well
 4 Industrial 8 Air Conditioning 12 Other

Was a chemical / bacteriological sample submitted to Department? Yes No X
 If yes, mo/day/yr sample was submitted

Water Well Disinfected: Yes X No

5 TYPE OF BLANK CASING USED:
 1 Steel 3 RMP (SR) 5 Wrought 7 Fiberglass 9 Other (Specify below)
 2 PVC 4 ABS 6 Asbestos-Cement 8 Concrete Tile

Blank casing diameter 8 in. Was casing pulled? Yes No X If yes, how much

Casing height above or below land surface 48 in.

6 GROUT PLUG MATERIAL: 1 Neat cement ~~2 Neat cement~~ Bentonite 4 Other

Grout Plug Intervals: From 4 ft. to 42 ft., From ft. to ft., From ft. to ft.

What is the nearest source of possible contamination:
 1 Septic tank 6 Seepage pit 11 Fuel storage 16 Other (specify below)
 2 Sewer lines 7 Pit privy 12 Fertilizer storage

3 Watertight sewer lines 8 Sewage lagoon 13 Insecticide storage

4 Lateral lines 9 Feedyard 14 Abandoned water well

5 Cess Pool 10 Livestock pens 15 Oil well/Gas well

Direction from well? None within 1/2 mile How many feet?

FROM	TO	PLUGGING MATERIALS
0	4	Top Soil
4	42	Bentonite-Hole Plug

City believes well was NEVER USED. No RECORDS OF it being pumped OR PERMITTED.

7 CONTRACTOR'S OR LANDOWNER'S CERTIFICATION: This water well was plugged under my jurisdiction and was completed on (mo/day/year) 10-5-03 and this record is true to the best of my knowledge and belief. Kansas Water Well Contractor's License No. 138 This Water Well Record was completed on (mo/day/year) 11-3-03 under the business name of Peterson Irrigation by (signature) Mike Peterson

INSTRUCTIONS: Use typewriter or ball point pen. Please press firmly and print clearly. Please fill in blanks, underline or circle the correct answers. Send top three copies to Kansas Department of Health and Environment, Bureau of Water, Topeka, Kansas 66620-0001. Telephone: 785/296-3565. Send one to Water Well Owner and retain one for your records.