

mw-2


1 LOCATION OF WATER WELL: County: <i>Chase</i>	Fraction <i>NW 1/4 NW 1/4 SW 1/4</i>	Section Number <i>28</i>	Township Number <i>T 19 S</i>	Range Number <i>R 8 E/W</i>
---	---	-----------------------------	----------------------------------	--------------------------------

Distance and direction from nearest town or city street address of well if located within city?

201 Walnut, Cottonwood Falls

2 WATER WELL OWNER: RR#, St. Address, Box # : City, State, ZIP Code	<i>Chase Co. Hwy Dept Attn: Elmer Swift P.O. Box 130, Cottonwood Falls</i>	Board of Agriculture, Division of Water Resources Application Number: <i>—</i>
---	--	---

3 LOCATE WELL'S LOCATION WITH AN "X" IN SECTION BOX:

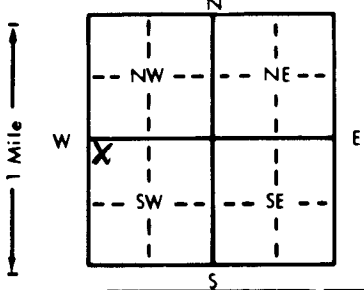

4 DEPTH OF COMPLETED WELL *20.5* ft. ELEVATION: *—*

Depth(s) Groundwater Encountered 1. *—* ft. 2. *—* ft. 3. *—* ft.

WELL'S STATIC WATER LEVEL *11.56* ft. below land surface measured on mo/day/yr *3/12/98*

Pump test data: Well water was *—* ft. after *—* hours pumping *—* gpm

Est. Yield *—* gpm: Well water was *—* ft. after *—* hours pumping *—* gpm

Bore Hole Diameter *8.625* in. to *—* ft., and *—* in. to *—* ft.

WELL WATER TO BE USED AS:

5 Public water supply	8 Air conditioning	11 Injection well
1 Domestic	3 Feedlot	6 Oil field water supply
2 Irrigation	4 Industrial	7 Lawn and garden only
		10 Monitoring well <i>mw-2</i>

WAS a chemical/bacteriological sample submitted to Department? Yes *—* No *X*; If yes, mo/day/yr sample was submitted

Water Well Disinfected? Yes *—* No *X*

5 TYPE OF BLANK CASING USED:

1 Steel	3 RMP (SR)	5 Wrought iron	8 Concrete tile	CASING JOINTS: Glued <i>—</i> Clamped <i>—</i>
2 PVC	4 ABS	6 Asbestos-Cement	9 Other (specify below)	Welded <i>—</i>
		7 Fiberglass		Threaded <i>X</i>

Blank casing diameter *2* in. to *10.5* ft., Dia *—* in. to *—* ft., Dia *—* in. to *—* ft.

Casing height above land surface *0* in., weight *sch 40* lbs./ft. Wall thickness or gauge No. *—*

TYPE OF SCREEN OR PERFORATION MATERIAL:

1 Steel	3 Stainless steel	5 Fiberglass	8 RMP (SR)	10 Asbestos-cement
2 Brass	4 Galvanized steel	6 Concrete tile	9 ABS	11 Other (specify) <i>—</i>

SCREEN OR PERFORATION OPENINGS ARE:

1 Continuous slot	3 Mill slot	5 Gauzed wrapped	8 Saw cut	11 None (open hole)
2 Louvered shutter	4 Key punched	6 Wire wrapped	9 Drilled holes	
		7 Torch cut	10 Other (specify) <i>—</i>	

SCREEN-PERFORATED INTERVALS: From *10.5* ft. to *20.5* ft., From *—* ft. to *—* ft.

SAND
GRAVEL PACK INTERVALS: From *9.5* ft. to *20.5* ft., From *—* ft. to *—* ft.

6 GROUT MATERIAL: 1 Neat cement 2 *Cement grout* 3 Bentonite 4 Other *—*

Grout Intervals: From *2.0* ft. to *1.5* ft., From *3.75* ft. to *9.5* ft., From *—* ft. to *—* ft.

What is the nearest source of possible contamination:

1 Septic tank	4 Lateral lines	7 Pit privy	10 Livestock pens	14 Abandoned water well
2 Sewer lines	5 Cess pool	8 Sewage lagoon	11 Fuel storage	15 Oil well/Gas well
3 Watertight sewer lines	6 Seepage pit	9 Feedyard	12 Fertilizer storage	16 Other (specify below)
			13 Insecticide storage	<i>cont. site</i>

Direction from well? How many feet?

FROM	TO	LITHOLOGIC LOG	FROM	TO	PLUGGING INTERVALS
<i>0.0</i>	<i>1.0</i>	<i>Gravel</i>			
<i>1.0</i>	<i>20.5</i>	<i>clay w/ some silt</i>			
<i>20.5</i>	<i>TD</i>	<i>End of Borehole</i>			

7 CONTRACTOR'S OR LANDOWNER'S CERTIFICATION: This water well was (1) constructed, (2) reconstructed, or (3) plugged under my jurisdiction and was completed on (mo/day/year) *3/4/98* and this record is true to the best of my knowledge and belief. Kansas Water Well Contractor's License No. *585* This Water Well Record was completed on (mo/day/yr) *3/19/98* under the business name of *ACL* by (signature) *Elmer Swift*

OFFICE USE ONLY