


1 LOCATION OF WATER WELL: County: Chase Fraction: NE 1/4 NE 1/4 NW 1/4 Section Number: 36 Township Number: T 19 S Range Number: R 8 EW

Distance and direction from nearest town or city street address of well if located within city? From Cottonwood Falls 60 1/2 miles East on Gravel

2 WATER WELL OWNER: Boyitt Spom Inc.  
 RR#, St. Address, Box #: 120 North St Marys, KS  
 City, State, ZIP Code: St Marys, KS  
 Board of Agriculture, Division of Water Resources  
 Application Number:

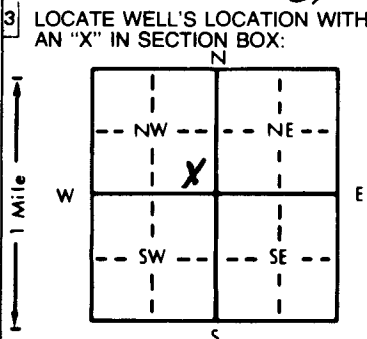

4 DEPTH OF COMPLETED WELL: 140 ft. ELEVATION:  
 Depth(s) Groundwater Encountered 1. 102 ft. 2. ft. 3. ft.  
 WELL'S STATIC WATER LEVEL: 90 ft. below land surface measured on mo/day/yr  
 Pump test data: Well water was ft. after hours pumping gpm  
 Est. Yield: 5 gpm Well water was ft. after hours pumping gpm  
 Bore Hole Diameter: 9 in. to 140 ft., and in. to ft.  
 WELL WATER TO BE USED AS:  
 Domestic 3 Feedlot 6 Oil field water supply 9 Dewatering 12 Other (Specify below)  
 2 Irrigation 4 Industrial 7 Lawn and garden only 10 Monitoring well  
 Was a chemical/bacteriological sample submitted to Department? Yes No; If yes, mo/day/yr sample was submitted

5 TYPE OF BLANK CASING USED:  
 1 Steel 3 RMP (SR) 5 Wrought iron 8 Concrete tile CASING JOINTS:  Glued  Clamped  
 PVC 4 ABS 6 Asbestos-Cement 9 Other (specify below)  Welded  
 7 Fiberglass  Threaded  
 Blank casing diameter: 5 in. to 120 ft., Dia. in. to ft., Dia. in. to ft.  
 Casing height above land surface: 3 in., weight 56.40 lbs./ft. Wall thickness or gauge No.  
 TYPE OF SCREEN OR PERFORATION MATERIAL:  
 1 Steel 3 Stainless steel 5 Fiberglass 8 RMP (SR) 10 Asbestos-cement  
 2 Brass 4 Galvanized steel 6 Concrete tile 9 ABS 11 Other (specify)  
 12 None used (open hole)  
 SCREEN OR PERFORATION OPENINGS ARE:  
 1 Continuous slot 3 Mill slot 25/1000's 5 Gauzed wrapped 8 Saw cut 11 None (open hole)  
 2 Louvered shutter 4 Key punched 6 Wire wrapped 9 Drilled holes  
 7 Torch cut 10 Other (specify)  
 SCREEN-PERFORATED INTERVALS: From 120 ft. to 140 ft., From ft. to ft.  
 GRAVEL PACK INTERVALS: From 25 ft. to 140 ft., From ft. to ft.

6 GROUT MATERIAL: 1 Neat cement 2 Cement grout  3 Bentonite 4 Other  
 Grout Intervals: From 0 ft. to 25 ft., From ft. to ft., From ft. to ft.  
 What is the nearest source of possible contamination: None Close  
 1 Septic tank 4 Lateral lines 7 Pit privy 10 Livestock pens 14 Abandoned water well  
 2 Sewer lines 5 Cess pool 8 Sewage lagoon 11 Fuel storage 15 Oil well/Gas well  
 3 Watertight sewer lines 6 Seepage pit 9 Feedyard 12 Fertilizer storage 16 Other (specify below)  
 13 Insecticide storage

Direction from well? How many feet?

FROM	TO	LITHOLOGIC LOG	FROM	TO	PLUGGING INTERVALS
0	1	Top Soil	123	126	Limstone
1	2	Limstone	126	140	Grey Shale
2	3	Yellow Shale			
3	6	Limstone			
6	21	Yellow Shale			
21	22	Limstone			
22	50	Brown Shale			
50	53	<del>Grey Shale</del> Limstone			
53	66	Grey Shale			
66	70	Limstone			
70	83	Grey Shale			
83	86	Limstone			
86	102	Greenish Shale			
102	107	Limstone (Water)			
107	123	Grey Shale			

7 CONTRACTOR'S OR LANDOWNER'S CERTIFICATION: This water well was  (1) constructed (2) reconstructed, or (3) plugged under my jurisdiction and was completed on (mo/day/year) 1/27/98 and this record is true to the best of my knowledge and belief. Kansas Water Well Contractor's License No. 451 This Water Well Record was completed on (mo/day/yr) 1/28/98  
 under the business name of Holdeman Well Drilling by (signature) Craig H. Cudde

INSTRUCTIONS: Use typewriter or ball point pen. PLEASE PRESS FIRMLY and PRINT clearly. Please fill in blanks, underline or circle the correct answers. Send top three copies to Kansas Department of Health and Environment, Bureau of Water, Topeka, Kansas 66620-0001. Telephone: 913-296-5445. Send one to WATER WELL OWNER and retain one for your records.

OFFICE USE ONLY