

WATER WELL RECORD


Form WWC-5

Division of Water Resources App. No.

1 LOCATION OF WATER WELL: County: Chase Fraction: 1/4 NW 1/4 NW 1/4 SW 1/4 Section Number: 20 Township No. T 19 S Range Number R 8 E W

Street/Rural Address of Well Location; if unknown, distance & direction from nearest town or intersection: Approximately 0.5 miles north and 1 mile west of Cottonwood Falls. Global Positioning System (GPS) information: Latitude: 38.383738 Longitude: -96.557076 Elevation: Unknown

2 WATER WELL OWNER: PWWSO #26 RR#, Street Address, Box #: 420 E. 4th St. City, State, ZIP Code: Strong City, KS 66869 Collection Method: GPS unit (Make/Model: WAAS)

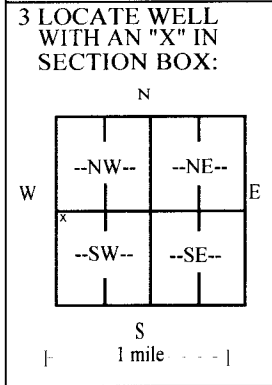

4 DEPTH OF COMPLETED WELL 50 ft. Depth(s) Groundwater Encountered (1) 13.80 ft. (2) ft. (3) ft. WELL'S STATIC WATER LEVEL 13.80 ft. below land surface measured on mo/day/yr 12/22/15 Pump test data: Well water was not checked ft. after hours pumping gpm EST. YIELD gpm. Well water was ft. after hours pumping gpm Bore Hole Diameter 9 in. to 55 ft., and in. to ft. WELL WATER TO BE USED AS: Public water supply Geothermal Injection well Domestic Feedlot Oil field water supply Dewatering Other (Specify below) Irrigation Industrial Domestic-lawn & garden Monitoring well Test Well Was a chemical/bacteriological sample submitted to Department? Yes No If yes, mo/day/yr sample was submitted Water well disinfected? Yes No

5 TYPE OF CASING USED: Steel PVC Other CASING JOINTS: Glued Clamped Welded Threaded Other (Specify) Casing diameter 5 in. to 38 ft., Diameter in. to ft., Diameter in. to ft. Casing height above land surface 24 in., Weight 2.36 lbs./ft., Wall thickness or gauge No. 214 TYPE OF SCREEN OR PERFORATION MATERIAL: Steel Stainless Steel PVC Other (Specify) Brass Galvanized Steel None used (open hole) SCREEN OR PERFORATION OPENINGS ARE: Continuous slot Mill slot Gauze wrapped Torch cut Drilled holes None (open hole) Louvered shutter Key punched Wire wrapped Saw cut Other (specify) SCREEN-PERFORATED INTERVALS: From 38 ft. to 48 ft., From ft. to ft. GRAVEL PACK INTERVALS: From 22 ft. to 55 ft., From ft. to ft.

6 GROUT MATERIAL: Neat cement Cement grout Bentonite Other Grout Intervals: From 0 ft. to 22 ft., From ft. to ft., From ft. to ft. What is the nearest source of possible contamination: Septic tank Lateral lines Pit privy Livestock pens Insecticide storage Other (specify below) Sewer lines Cesspool Sewage lagoon Fuel storage Abandoned water well OB-3-15 Watertight sewer lines Seepage pit Feedyard Fertilizer storage Oil well/gas well Direction from well North Distance from well 61'

Table with 6 columns: FROM, TO, LITHOLOGIC LOG, FROM, TO, LITHO. LOG (cont.) or PLUGGING INTERVALS. Rows include Topsoil, Clay, gray, brown, sticky, Sand, fine to coarse, Sand, gravel, fine to very coarse, Shale, black, Limestone, gray, hard.

7 CONTRACTOR'S OR LANDOWNER'S CERTIFICATION: This water well was constructed, reconstructed, or plugged under my jurisdiction and was completed on (mo/day/year) 12/22/15 and this record is true to the best of my knowledge and belief. Kansas Water Well Contractor's License No. 185 This Water Well Record was completed on (mo/day/year) 12/28/15 under the business name of Clarke Well & Equipment, Inc. by (signature)

INSTRUCTIONS: Use typewriter or ball point pen. PLEASE PRESS FIRMLY and PRINT clearly. Please fill in blanks and check the correct answers. Send three copies (white, blue, pink) to Kansas Department of Health and Environment, Bureau of Water, Geology Section, 1000 SW Jackson St., Suite 420, Topeka, Kansas 66612-1367. Telephone 785-296-5522. Send one copy to WATER WELL OWNER and retain one for your records. Include fee of \$5.00 for each constructed well. Visit us at http://www.kdheks.gov/waterwell/index.html.