To BWS 12-1-78

USE TYPEWRITER OR BALL POINT PEN-PRESS FIRMLY, PRINT CLEARLY.

WATER WELL RECORD
KSA 82a-1201-1215

Kansas Department of Health and Environment-Division of Environment
(Water well Contractors)
Topeka, Kansas 66620

1. Location of well:	County	Fraction	Section number	Township number	Range number
	Chase	SE 1/4 NW 1/4 NW 1/4	21	T 19 S	R 8 E/W

2. Distance and direction from nearest town or city: 700' East of Elm St. & 115' South of Church St.
Street address of well location if in city:

3. Owner of well: City of Strong City
R.R. or street: Strong City, Kansas 66869
City, state, zip code:

4. Locate with "X" in section below:

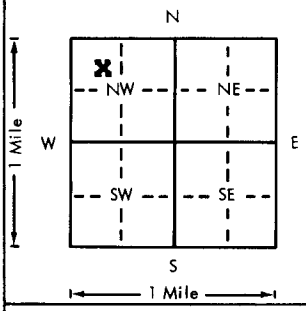

Sketch map: Well No. 1

6. Bore hole dia. 42 in. Completion date
Well depth 52 ft. 8/10/77

7. __ Cable tool __ Rotary __ Driven __ Dug
__ Hollow rod __ Jetted __ Bored X Reverse rotary

8. Use: __ Domestic X Public supply __ Industry
__ Irrigation __ Air conditioning __ Stock
__ Lawn __ Oil field water __ Other

9. Casing: Material steel Height: Above ~~XXXXX~~
Threaded ___ Welded X Surface 30 in.
RMP ___ PVC ___ Weight 43.77 lbs./ft.
Dia. 12 in. to 34 ft. depth Wall Thickness: inches or
47' to 52 ft. depth gage No. 0.330"

5. Type and color of material	From	To
Top soil	0	2
Brown clay	2	23
Blue-brown clay & fine sand	23	38
Small to med. loose rock	38	47
Gray shale	47	54

(Use a second sheet if needed)

10. Screen: Manufacturer's name Mustang Wire Wrap
Type Stainless Dia. 12'
Slot/gauze #70 Length 13'
Set between 34 ft. and 47 ft.
ft. and ft.
Gravel pack? yes Size range of material 1/8x1/4

11. Static water level: mo./day/yr.
14.5 ft. below land surface Date 8/10/77

12. Pumping level below land surfaces:
35 ft. after 7 hrs. pumping 150 g.p.m.
39.6 ft. after 1 hrs. pumping 175 g.p.m.
Estimated maximum yield 150 g.p.m.

13. Water sample submitted: mo./day/yr.
__ Yes X No Date

14. Well head completion:
__ Pitless adapter 30 Inches above grade

15. Well grouted? yes
With: __ Neat cement __ Bentonite X Concrete
Depth: From 7 ft. to 27 ft.

16. Nearest source of possible contamination: Sewer Line
ft. 380 Direction West Type
Well disinfected upon completion? X Yes __ No

17. Pump: ■ Not installed
Manufacturer's name Layne & Bowler
Model number 6DRMSLC HP 5 Volts 240
Length of drop pipe 38 ft. capacity 100 g.p.m.
Type:
X Submersible __ Turbine
__ Jet __ Reciprocating
__ Centrifugal __ Other

18. Elevation:

Topography:
__ Hill
__ Slope
__ Upland
X Valley

19. Remarks:

20. Water well contractor's certification:
This well was drilled under my jurisdiction and this report is true to the best of my knowledge and belief.
Layne Western Co. 102
Business name License No.
Address Wichita, Kansas
Signed Larry G. Krall Date 11/30/78
Authorized representative

T 19 S R 8 E/W Sec 21 1/4 SE 1/4 NW 1/4 NW 1/4

Forward the white, blue and pink copies to the Department of Health and Environment

Form WWC-5

MI-1023