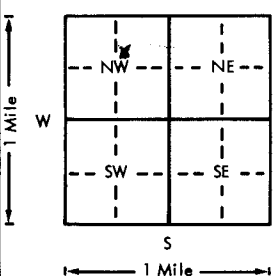
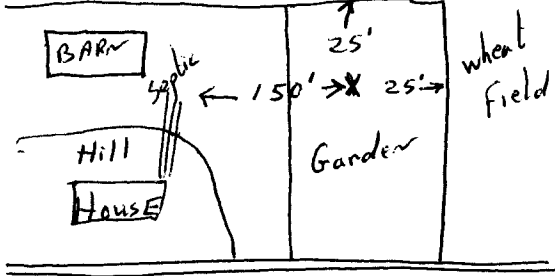


USE TYPEWRITER OR BALL
POINT PEN-PRESS FIRMLY,
PRINT CLEARLY.

WATER WELL RECORD
KSA 82a-1201-1215

Kansas Department of Health and
Environment-Division of Environment
(Water well Contractors)
Topeka, Kansas 66620

1. Location of well:		County Chase	Fraction SW 1/4 NE 1/4 NW 1/4	Section number 29	Township number T 19 S R 8 E/W	Range number 8 E/W
2. Distance and direction from nearest town or city: Street address of well location if in city:			3. Owner of well: R.R. or street: City, state, zip code:			
2. Distance and direction from nearest town or city: 1/4 mile west of Cottonwood Falls Street address of well location if in city:			3. Owner of well: Pretzen R.R. or street: Cottonwood Falls City, state, zip code: Kan.			
4. Locate with "X" in section below:		Sketch map:		6. Bore hole dia. 7 in. Completion date 12-15-76 Well depth 51 ft.		
N  W E S 1 Mile		wheat field  wheat field		7. <input checked="" type="checkbox"/> Cable tool <input type="checkbox"/> Rotary <input type="checkbox"/> Driven <input type="checkbox"/> Dug <input type="checkbox"/> Hollow rod <input type="checkbox"/> Jetted <input type="checkbox"/> Bored <input type="checkbox"/> Reverse rotary		
5. Type and color of material		From		To		8. Use: <input checked="" type="checkbox"/> Domestic <input type="checkbox"/> Public supply <input type="checkbox"/> Industry <input type="checkbox"/> Irrigation <input type="checkbox"/> Air conditioning <input type="checkbox"/> Stock <input type="checkbox"/> Lawn <input type="checkbox"/> Oil field water <input type="checkbox"/> Other
Topsoil - Blk		0		23		9. Casing: Material plts Height Above or below Threaded <input type="checkbox"/> Welded glw Surface 14 in. RMP A PVC <input type="checkbox"/> Weight 14 lbs./ft. Dia. 5 in. to 35 ft. depth; Wall Thickness: inches or Dia. 5 in. to 35 ft. depth; gage No. 1200
Clay - Red		3		16		10. Screen: Manufacturer's name Sunflower Type RMP Dia. 5" Slot/gauze 1/8 Length 16' Set between 35 ft. and 51 ft. Gravel pack? Yes Size range of material 1/8 - 1/2
Shale - Gray Flint Gravel		16		21		11. Static water level: 25 ft. below land surface Date 12-15-76
Lime - Gray		21		23		12. Pumping level below land surfaces: ____ ft. after ____ hrs. pumping ____ g.p.m. ____ ft. after ____ hrs. pumping ____ g.p.m. Estimated maximum yield 15 g.p.m.
Shale - Gray		23		28		13. Water sample submitted: ____ mo./day/yr. Yes <input type="checkbox"/> No <input checked="" type="checkbox"/> Date ____
Lime / Flint Gray		28		33		14. Well head completion: ____ Pitless adapter 14 inches above grade
Shale - Blue		33		34		15. Well grouted? Yes With: <input type="checkbox"/> Neat cement <input type="checkbox"/> Bentonite <input checked="" type="checkbox"/> Concrete Depth: From 4 ft. to 14 ft.
Lime - Gray		34		38		16. Nearest source of possible contamination: ft. 150 Direction W Type Septic Well disinfected upon completion? <input checked="" type="checkbox"/> Yes <input type="checkbox"/> No
Shale - Gray		38		41		17. Pump: <input checked="" type="checkbox"/> Not installed Manufacturer's name ____ HP ____ Volts ____ Length of drop pipe ____ ft. capacity ____ g.p.m. Type: <input type="checkbox"/> Submersible <input type="checkbox"/> Turbine <input type="checkbox"/> Jet <input type="checkbox"/> Reciprocating <input type="checkbox"/> Centrifugal <input type="checkbox"/> Other
Lime - Wht		41		43		20. Water well contractor's certification: This well was drilled under my jurisdiction and this report is true to the best of my knowledge and belief. Zinn Water Well Drilling 218 Business name Lost Springs, Kan License No. ____ Address George A. Zinn Date 12-15-76 Signed George A. Zinn Authorized representative
Shale - Blk		43		44		
Lime		44		45		
Shale Black		45		51		
(Use a second sheet if needed)						
18. Elevation:		19. Remarks:		20. Water well contractor's certification:		
Topography: <input type="checkbox"/> Hill <input type="checkbox"/> Slope <input type="checkbox"/> Upland <input checked="" type="checkbox"/> Valley		Concrete slab 4'x4'x4" to be responsibility of customer X Jerry Pretzen		Zinn Water Well Drilling 218 Business name Lost Springs, Kan License No. ____ Address George A. Zinn Date 12-15-76 Signed George A. Zinn Authorized representative		

Forward the white, blue and pink copies to the Department of Health and Environment

Form WWC-5