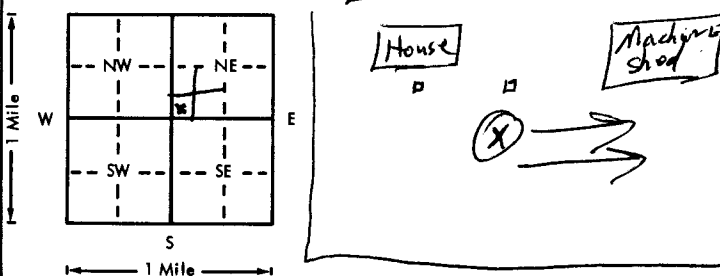


USE TYPEWRITER OR BALL-POINT PEN PRESS FIRMLY. PRINT CLEARLY.

WATER WELL RECORD  
KSA 82a-1201-1215

Kansas Department of Health and  
Environment-Division of Environment  
(Water well Contractors)  
Topeka, Kansas 66620

1. Location of well: Township: <u>T 19 S</u> Range: <u>R 8 E</u>		Fraction: <u>SW 1/4 SW 1/4 NE 1/4</u>	Section number: <u>35</u>
2. Distance and direction from nearest town or city: <u>2 1/2 mile East</u> Street address of well location if in city: <u>8th Cottonwood Falls</u>		3. Owner of well: <u>Floyd Dexter</u> R.R. or street: <u>Cottonwood Falls</u> City, state, zip code: <u>Kan</u>	
4. Locate with "X" in section below: 		6. Bore hole dia. <u>7</u> in. Completion date <u>12-10-76</u> Well depth <u>50</u> ft.	
5. Type and color of material		7. <input checked="" type="checkbox"/> Cable tool <input type="checkbox"/> Rotary <input type="checkbox"/> Driven <input type="checkbox"/> Dug <input type="checkbox"/> Hollow rod <input type="checkbox"/> Jetted <input type="checkbox"/> Bored <input type="checkbox"/> Reverse rotary	
Topsoil - <u>Blk</u>		8. Use: <input checked="" type="checkbox"/> Domestic <input type="checkbox"/> Public supply <input type="checkbox"/> Industry <input type="checkbox"/> Irrigation <input type="checkbox"/> Air conditioning <input type="checkbox"/> Stock <input type="checkbox"/> Lawn <input type="checkbox"/> Oil field water <input type="checkbox"/> Other	
Clay - <u>Red</u>		9. Casing: Material <u>Pipes</u> Height: Above or below Threaded <input type="checkbox"/> Welded <input checked="" type="checkbox"/> Surface <u>16</u> in. <input checked="" type="checkbox"/> PVC <input type="checkbox"/> Weight <u>16</u> lbs./ft. Dia. <u>5</u> in. to <u>40</u> ft. depth Wall Thickness: inches or Dia. <u>5</u> in. to <u>40</u> ft. depth gage No. <u>200</u>	
Shale - <u>Gray</u>		10. Screen: Manufacturer's name <u>Sunflower</u> Type <u>RMP</u> Dia. <u>5"</u> Slot/gauge <u>1/8</u> Length <u>10'</u> Set between <u>40</u> ft. and <u>50'</u> ft. Gravel pack? <u>Yes</u> Size range of material <u>1/4-1/2"</u>	
Lime - <u>Gray</u>		11. Static water level: <u>35</u> ft. below land surface Date <u>12-10-76</u>	
Shale - <u>Blk</u>		12. Pumping level below land surfaces: ____ ft. after ____ hrs. pumping ____ g.p.m. ____ ft. after ____ hrs. pumping ____ g.p.m. Estimated maximum yield <u>10</u> g.p.m.	
Lime & Flint <u>Gray</u>		13. Water sample submitted: ____ mo./day/yr. Yes <input type="checkbox"/> No <input checked="" type="checkbox"/> Date ____	
Shale - <u>Gray</u>		14. Well head completion: ____ Pitless adapter <u>16</u> inches above grade	
Lime - <u>Gray</u>		15. Well grouted? <u>Yes</u> With: ____ Neat cement ____ Bentonite <input checked="" type="checkbox"/> Concrete Depth: From <u>5</u> ft. to <u>16</u> ft.	
Shale - <u>Brn</u>		16. Nearest source of possible contamination: ft. <u>200</u> Direction <u>NW</u> Type <u>Septic</u> Well disinfected upon completion? <input checked="" type="checkbox"/> Yes <input type="checkbox"/> No	
Lime - <u>Gray</u>		17. Pump: <input checked="" type="checkbox"/> Not installed Manufacturer's name ____ Model number ____ HP ____ Volts ____ Length of drop pipe ____ ft. capacity ____ g.p.m. Type: ____ Submersible ____ Turbine ____ Jet ____ Reciprocating ____ Centrifugal ____ Other	
18. Elevation:		20. Water well contractor's certification: This well was drilled under my jurisdiction and this report is true to the best of my knowledge and belief. Business name <u>Water Well Drilling</u> License No. <u>218</u> Address <u>West Springs, Kan</u> Signed <u>Joseph A. Zain</u> Date <u>12-10-76</u> Authorized representative	
19. Remarks: <u>Concrete slab 4' x 4' x 4" around well, will be installed by customer x Floyd W. Dexter</u>			

Forward the white, blue and pink copies to the Department of Health and Environment

Form WWC-5