


1 LOCATION OF WATER WELL: Fraction NW 1/4 NW 1/4 NE 1/4 Section Number 24 Township Number T 19 S Range Number R 22 E
 County: CHASE

Distance and direction from nearest town or city street address of well if located within city?
APPROX 4 M E of STRONG CITY KS.

2 WATER WELL OWNER: RUBIN R ROBERTS
 RR#, St. Address, Box #: 508 COTTONWOOD 66869
 Board of Agriculture, Division of Water Resources
 Application Number:

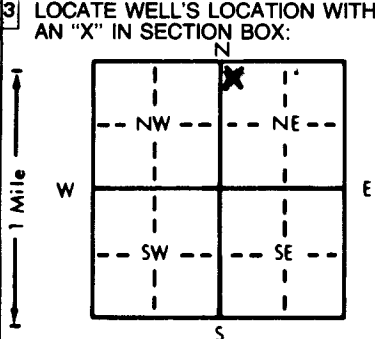

4 DEPTH OF COMPLETED WELL: 76 ft. ELEVATION:
 Depth(s) Groundwater Encountered 1. 32 ft. 2. 47 ft. 3. ft.
 WELL'S STATIC WATER LEVEL 31 ft. below land surface measured on mo/day/yr 05-24-89
 Pump test data: Well water was ft. after hours pumping gpm
 Est. Yield 257 gpm: Well water was ft. after hours pumping gpm
 Bore Hole Diameter 10 in. to 7.6 ft., and in. to ft.
 WELL WATER TO BE USED AS:
 1 Domestic 3 Feedlot 6 Oil field water supply 9 Dewatering 12 Other (Specify below)
 2 Irrigation 4 Industrial 7 Lawn and garden only 10 Monitoring well
 Was a chemical/bacteriological sample submitted to Department? Yes No X; If yes, mo/day/yr sample was submitted
 Water Well Disinfected? Yes X No

5 TYPE OF BLANK CASING USED:
 1 Steel 3 RMP (SR) 6 Asbestos-Cement 9 Other (specify below) Welded
 2 PVC 4 ABS 7 Fiberglass Threaded
 Blank casing diameter 6 in. to 7.6 ft., Dia. in. to ft., Dia. in. to ft.
 Casing height above land surface 4.8 in., weight 18.0 lbs./ft. Wall thickness or gauge No.
 TYPE OF SCREEN OR PERFORATION MATERIAL:
 1 Steel 3 Stainless steel 5 Fiberglass 7 PVC 10 Asbestos-cement
 2 Brass 4 Galvanized steel 6 Concrete tile 8 RMP (SR) 11 Other (specify)
 9 ABS 12 None used (open hole)
 SCREEN OR PERFORATION OPENINGS ARE:
 1 Continuous slot 5 Gauzed wrapped 8 Saw cut 11 None (open hole)
 2 Louvered shutter 3 Mill slot 6 Wire wrapped 9 Drilled holes
 4 Key punched 7 Torch cut 10 Other (specify)
 SCREEN-PERFORATED INTERVALS: From 3.0 ft. to 3.5 ft., From 4.0 ft. to 6.5 ft.
 From ft. to ft., From ft. to ft.
 GRAVEL PACK INTERVALS: From 2.9 ft. to 7.6 ft., From ft. to ft.
 From ft. to ft., From ft. to ft.

6 GROUT MATERIAL: 1 Neat cement 2 Cement grout 3 Bentonite 4 Other
 Grout Intervals: From 13.5 ft. to 1.5 ft., From ft. to ft., From ft. to ft.
 What is the nearest source of possible contamination: NA - AS OF THIS DATE
 1 Septic tank 4 Lateral lines 7 Pit privy 10 Livestock pens 14 Abandoned water well
 2 Sewer lines 5 Cess pool 8 Sewage lagoon 11 Fuel storage 15 Oil well/Gas well
 3 Watertight sewer lines 6 Seepage pit 9 Feedyard 12 Fertilizer storage 16 Other (specify below)
 13 Insecticide storage
 Direction from well? How many feet?

FROM	TO	LITHOLOGIC LOG	FROM	TO	PLUGGING INTERVALS
0	1.5	CLAY FILL	30.5	32	LIME
1.5	3.5	LIME	32	34	SHALE
3.5	5	CLAY	34	47	SHALE -
5	10	LIME	47	48	LIME - OFF WHITE
10	11	CLAY	48	50	SHALE " "
11	13.5	LIME	50	58	SHALE VERY LT GR
13.5	22	SHALE LT GREY	58	58.5	" RED ROCK "
22	24.5	SHALE DK GREY	58.5	61	SHALE
24.5	25	LIME	61	62	LIME
25	25.5	SHALE -	62	65.5	SHALE
25.5	27	LIME	65.5	67.5	LIME
27	29	CLAY FILLED	67.5	75	SHALE DK GR
29	30	LIME	75	76	TD - LIME
30	30.5	SHALE			

7 CONTRACTOR'S OR LANDOWNER'S CERTIFICATION: This water well was constructed, (2) reconstructed, or (3) plugged under my jurisdiction and was completed on (mo/day/year) 05-24-89 and this record is true to the best of my knowledge and belief. Kansas Water Well Contractor's License No. 479 This Water Well Record was completed on (mo/day/yr) 05-25-89 under the business name of EBBERTS DRILLING by (signature) Gregory Ebberts

INSTRUCTIONS: Use typewriter or ball point pen. PLEASE PRESS FIRMLY and PRINT clearly. Please fill in blanks, underline or circle the correct answers. Send top three copies to Kansas Department of Health and Environment, Bureau of Water Protection, Topeka, Kansas 66620-7320. Telephone: 913-296-5514. Send one to WATER WELL OWNER and retain one for your records.

OFFICE USE ONLY
T
R
EW
SEC.
1/4
1/4
1/4