


1 LOCATION OF WATER WELL: Fraction SE Section Number 18 Township Number 19 Range Number 9E
 County: CHASE S 1/4 SW 1/4 SE 1/4

N/D I
THURSTON

Distance and direction from nearest town or city street address of well if located within city?
4 1/2 East Strong City

2 WATER WELL OWNER: Thurston Family Living Trust
 RR#, St. Address, Box #: Roca Thurston, Trustee Board of Agriculture, Division of Water Resources
 City, State, ZIP Code: PO Box 85 Cottonwood Falls, KS. Application Number: NA

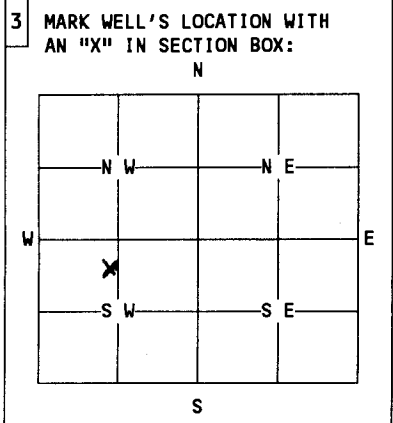

4 DEPTH OF WELL.....27.....ft.
 WELL'S STATIC WATER LEVEL.....22.....ft.
 WELL WAS USED AS:
 1 Domestic 5 Public Water Supply 9 Dewatering
 2 Irrigation 6 Oil Field Water Supply 10 Monitoring Well
 3 Feedlot 7 Lawn and Garden Only 11 Injection Well
 4 Industrial 8 Air Conditioning 12 Other.....
 Was a chemical/bacteriological sample submitted to Department? Yes.....No .
 If yes, mo/day/yr sample was submitted.....
 Water Well Disinfected: Yes ... No.....

5 TYPE OF BLANK CASING USED: 36" Rock Wall Cement Laid to 8'
 1 Steel 3 RMP (SR) 5 Wrought 7 Fiberglass 9 Other (specify below)
 2 PVC 4 ABS 6 Asbestos-Cement 8 Concrete Tile
 Blank casing diameter.....36.....in. Was casing pulled? Yes..... No..... If yes, how much.....
 Casing height above or below land surface.....in.

6 GROUT PLUG MATERIAL: 1 Neat cement 2 Cement grout 3 Bentonite 4 Other.....
 Grout Plug Intervals: From 12.ft. to 14.ft., From.....ft. toft., From..... to.....ft.
 What is the nearest source of possible contamination:
 1 Septic tank 6 Seepage pit 11 Fuel storage 16 Other (specify below)
 2 Sewer lines 7 Pit privy 12 Fertilizer storage
 3 Watertight sewer lines 8 Sewage lagoon 13 Insecticide storage
 4 Lateral lines 9 Feedyard 14 Abandoned water well
 5 Cess Pool 10 Livestock pens 15 Oil well/Gas well
 Direction from well?SW..... How many feet?50'.....

FROM	TO	PLUGGING MATERIALS
0	12	Clay
12	14	Bentonite
14	18	Clay
18	27	Rock + Pack

Disinfect well Pump.
 Down from 17' static.
 Disinfect well returned
 to 22' in 12 hrs. Remove
 curbs + 10' top wall
 Fill to 18' with pack. Fill
 to 14' clay 14 to 12 Bentonite
 12 to surface clay.

7 CONTRACTOR'S OR LANDOWNER'S CERTIFICATION: This water well was plugged under my jurisdiction and was completed on (mo/day/year) 12-30-96 and this record is true to the best of my knowledge and belief. Kansas Water Well Contractor's License No. 203 This Water Well Record was completed on (mo/day/year) 12-30-96 under the business name of Mallett Drilling & Metals
 by (signature) J.R. Mallett

INSTRUCTIONS: Use typewriter or ball point pen. Please press firmly and print clearly. Please fill in blanks, underline or circle the correct answers. Send top three copies to Kansas Department of Health and Environment, Bureau of Water, Topeka, Kansas 66620-0001. Telephone: 913/296-3565. Send one to Water Well Owner and retain one for your records.