


1 LOCATION OF WATER WELL: Fraction SW 1/4 SW 1/4 NW 1/4 Section Number 7 Township Number T 19 S Range Number R 9 E

Distance and direction from nearest town or city street address of well if located within city?  
4 1/2 Mile East & 1/4 North

2 WATER WELL OWNER: Woody Shoemaker  
 RR#, St. Address, Box #: Rt 1 Box 53  
 City, State, ZIP Code: Strang City, Ks 66869  
 Board of Agriculture, Division of Water Resources  
 Application Number:

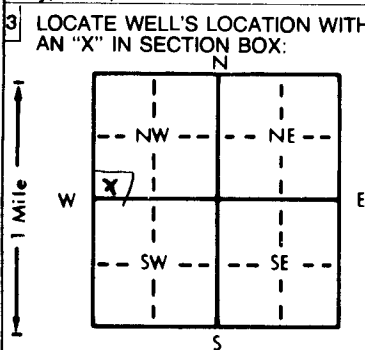

4 DEPTH OF COMPLETED WELL: 70' ft. ELEVATION:  
 Depth(s) Groundwater Encountered 1. 12 ft. 2. \_\_\_\_\_ ft. 3. \_\_\_\_\_ ft.  
 WELL'S STATIC WATER LEVEL: 6 ft. below land surface measured on mo/day/yr May 16-99  
 Pump test data: Well water was \_\_\_\_\_ ft. after \_\_\_\_\_ hours pumping \_\_\_\_\_ gpm  
 Est. Yield 3 gpm. Well water was \_\_\_\_\_ ft. after \_\_\_\_\_ hours pumping \_\_\_\_\_ gpm  
 Bore Hole Diameter: 8 5/8 in. to 15 ft. and 2 7/8 in. to 70 ft.  
 WELL WATER TO BE USED AS:  
 1 Domestic     3 Feedlot     6 Oil field water supply     9 Dewatering     12 Other (Specify below)  
 2 Irrigation     4 Industrial     7 Lawn and garden only     10 Monitoring well  
 Was a chemical/bacteriological sample submitted to Department? Yes \_\_\_\_\_ No  If yes, mo/day/yr sample was submitted \_\_\_\_\_  
 Water Well Disinfected?  Yes     No

5 TYPE OF BLANK CASING USED:  
 1 Steel     3 RMP (SR)     5 Wrought iron     8 Concrete tile    CASING JOINTS: Glued  Clamped \_\_\_\_\_  
 2 PVC     4 ABS     6 Asbestos-Cement     9 Other (specify below)    Welded \_\_\_\_\_  
 \_\_\_\_\_     7 Fiberglass    \_\_\_\_\_    Threaded \_\_\_\_\_  
 Blank casing diameter: 5 in. to 12 ft. Dia \_\_\_\_\_ in. to \_\_\_\_\_ ft. Dia \_\_\_\_\_ in. to \_\_\_\_\_ ft.  
 Casing height above land surface: 18 in. weight \_\_\_\_\_ lbs./ft. Wall thickness or gauge No. SPR-26  
 TYPE OF SCREEN OR PERFORATION MATERIAL:  
 1 Steel     3 Stainless steel     5 Fiberglass     7 PVC     10 Asbestos-cement  
 2 Brass     4 Galvanized steel     6 Concrete tile     8 RMP (SR)     11 Other (specify) \_\_\_\_\_  
 9 ABS     12 None used (open hole)  
 SCREEN OR PERFORATION OPENINGS ARE:  
 1 Continuous slot     5 Gauzed wrapped     8 Saw cut     11 None (open hole)  
 2 Louvered shutter     3 Mill slot     6 Wire wrapped     9 Drilled holes  
 4 Key punched     7 Torch cut     10 Other (specify) \_\_\_\_\_  
 SCREEN-PERFORATED INTERVALS: From 12 ft. to 70 ft. From \_\_\_\_\_ ft. to \_\_\_\_\_ ft.  
 GRAVEL PACK INTERVALS: From 12 ft. to 70 ft. From \_\_\_\_\_ ft. to \_\_\_\_\_ ft.

6 GROUT MATERIAL:  1 Neat cement     2 Cement grout     3 Bentonite     4 Other \_\_\_\_\_  
 Grout Intervals: From 3 ft. to 12 ft. From \_\_\_\_\_ ft. to \_\_\_\_\_ ft. From \_\_\_\_\_ ft. to \_\_\_\_\_ ft.  
 What is the nearest source of possible contamination:  
 1 Septic tank     4 Lateral lines     7 Pit privy     10 Livestock pens     14 Abandoned water well  
 2 Sewer lines     5 Cess pool     8 Sewage lagoon     11 Fuel storage     15 Oil well/Gas well  
 3 Watertight sewer lines     6 Seepage pit     9 Feedyard     12 Fertilizer storage     16 Other (specify below)  
 13 Insecticide storage  
 Direction from well? North How many feet? 65

FROM	TO	LITHOLOGIC LOG	FROM	TO	PLUGGING INTERVALS
0	2	Top Soil			
2	12	Clay TAN			
12	14	Gravel			
14	15	LIME White			
15	20	Shale Gray			
20	21	LIME Gray			
21	24	Shale Gray			
24	29	LIME Gray			
29	33	Shale Gray			
33	36	LIME Gray			
36	45	Shale Gray			
45	53	LIME Gray			
53	57	Shale Dk Gray			
57	62	LIME Lite Gray			
62	70	Shale Gray			

7 CONTRACTOR'S OR LANDOWNER'S CERTIFICATION: This water well was  (1) constructed,  (2) reconstructed, or  (3) plugged under my jurisdiction and was completed on (mo/day/year) MAY 16-99 and this record is true to the best of my knowledge and belief. Kansas Water Well Contractor's License No. 218 This Water Well Record was completed on (mo/day/yr) \_\_\_\_\_ under the business name of Zinn Water Well Drng by (signature) Joseph A. Zinn

OFFICE USE ONLY  
T  
R  
EW  
SEC.  
1/4  
1/4  
1/4