

CORRECTION TO WATER WELL RECORD (WWC-5)

The following correction(s) was made to the attached WWC-5 log, in order to file the item or to rectify lacking or incorrect information.

change

Fraction (1/4 1/4 1/4) Section-Township-Range changed:

listed as NW SW NW 6 - 19S - 8E

changed to NW SW NW 6 - 19S - 9E

Other changes: Initial statements: _____

Changed to: _____

Comments: _____

verification method: Bob Sawin tape + field

initials: _____ date: 2-23-01


submitted by: Kansas Geological Survey, Data Resources Library, 1930 Constant Ave., Lawrence, KS 66047-3726
to: Kansas Dept of Health & Environment Bureau of Water Industrial Programs, Bldg 283, Forbes Field, KS 66620

1 LOCATION OF WATER WELL: County: CHASE Fraction: NW 1/4 SW 1/4 RW 1/4 Section Number: 6 Township Number: T 19 S Range Number: R 8 **EW**

Distance and direction from nearest town or city street address of well if located within city?
4 M E 1 1/2 N OF STRONG CITY KS

2 WATER WELL OWNER: GLADYS BIGGS
 RR#, St. Address, Box #: RR 1 BOX 24
 City, State, ZIP Code: STRONG CITY - 66869
 Board of Agriculture, Division of Water Resources
 Application Number:

3 LOCATE WELL'S LOCATION WITH AN "X" IN SECTION BOX:

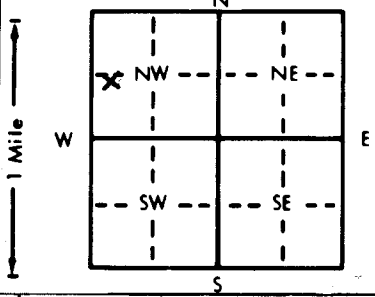

4 DEPTH OF COMPLETED WELL: 32 ft. ELEVATION:
 Depth(s) Groundwater Encountered 1. 28 ft. 2. - ft. 3. - ft.
 WELL'S STATIC WATER LEVEL: 22 ft. below land surface measured on mo/day/yr 03-22-89
 Pump test data: Well water was - ft. after - hours pumping - gpm
 Est. Yield: .8 gpm: Well water was 48 GPH ft. after - hours pumping - gpm
 Bore Hole Diameter: 1.0 in. to 32 ft., and - in. to - ft.
 WELL WATER TO BE USED AS:
 5 Public water supply 8 Air conditioning 11 Injection well
 1 Domestic 3 Feedlot 6 Oil field water supply 9 Dewatering **12 Other (Specify below)**
 2 Irrigation 4 Industrial 7 Lawn and garden only 10 Monitoring well PASTURE - LIVESTOCK
 Was a chemical/bacteriological sample submitted to Department? Yes - No X; If yes, mo/day/yr sample was submitted
 Water Well Disinfected? Yes X No

5 TYPE OF BLANK CASING USED:
 1 Steel 3 RMP (SR) 5 Wrought iron 8 Concrete tile CASING JOINTS: Glued X Clamped -
2 PVC 4 ABS 6 Asbestos-Cement 9 Other (specify below) Welded -
 7 Fiberglass Threaded -

Blank casing diameter: 6 in. to 32 ft., Dia - in. to - ft., Dia - in. to - ft.
 Casing height above land surface: 24 in., weight 160 lbs./ft. Wall thickness or gauge No. -

TYPE OF SCREEN OR PERFORATION MATERIAL:
 1 Steel 3 Stainless steel 5 Fiberglass 7 PVC 10 Asbestos-cement
 2 Brass 4 Galvanized steel 6 Concrete tile 8 RMP (SR) 11 Other (specify) -
 12 None used (open hole)

SCREEN OR PERFORATION OPENINGS ARE:
 1 Continuous slot 3 Mill slot 5 Gauzed wrapped 8 Saw cut 11 None (open hole)
 2 Louvered shutter 4 Key punched 6 Wire wrapped 9 Drilled holes
 7 Torch cut 10 Other (specify) -

SCREEN-PERFORATED INTERVALS: From 22 ft. to 32 ft., From - ft. to - ft., From - ft. to - ft.
 GRAVEL PACK INTERVALS: From 20 ft. to 32 ft., From - ft. to - ft., From - ft. to - ft.

6 GROUT MATERIAL: 1 Neat cement 2 Cement grout 3 Bentonite 4 Other -
 Grout Intervals: From 1 ft. to 12 ft., From - ft. to - ft., From - ft. to - ft.

What is the nearest source of possible contamination:
 1 Septic tank 4 Lateral lines 7 Pit privy 10 Livestock pens 14 Abandoned water well
 2 Sewer lines 5 Cess pool 8 Sewage lagoon 11 Fuel storage 15 Oil well/Gas well
 3 Watertight sewer lines 6 Seepage pit 9 Feedyard 12 Fertilizer storage 16 Other (specify below)
13 Insecticide storage NOTHING IN AREA

Direction from well? How many feet?

FROM	TO	LITHOLOGIC LOG	FROM	TO	PLUGGING INTERVALS
		<u>UNKNOWN - NO HISTORY</u>			<u>STEEL PIPE</u>
		<u>CEMENT TOP WAS MARKED - 1946</u>			<u>TOP PLATE</u>
		<u>LIFTING BY WINDMILL</u>			<u>22' GL</u>
					<u>6" PVC</u>
					<u>NEAT CEMENT</u>
					<u>1800# GRAVEL PACK</u>
					<u>WASH OUT</u>
					<u>1.25" PIPE IN HOLE</u>

7 CONTRACTOR'S OR LANDOWNER'S CERTIFICATION: This water well was (1) constructed, (2) reconstructed, or (3) plugged under my jurisdiction and was completed on (mo/day/year) 03-22-89 and this record is true to the best of my knowledge and belief. Kansas Water Well Contractor's License No. 479 This Water Well Record was completed on (mo/day/yr) 03-23-89 under the business name of EBBERTS DRILLING by (signature) Argan Ebberts

OFFICE USE ONLY