

1 LOCATION OF WATER WELL: Fraction SE 1/4 SE 1/4 Section Number 12 Township Number T 19 -8 Range Number R 9 EW


Distance and direction from nearest town or city street address of well if located within city? HIWAY 50 W-DFEMPORIA AND CHASE CO. SIDE IF LYON AND CHASE COS.LINE

2 WATER WELL OWNER: K-DAT RR#, St. Address, Box #: STATE OFFICE BUILD City, State, ZIP Code: TOPERA KS 66603 Board of Agriculture, Division of Water Resources Application Number:

3 LOCATE WELL'S LOCATION WITH AN "X" IN SECTION BOX: (Diagram showing a 4-section grid with 'X' in the SE section) 4 DEPTH OF COMPLETED WELL UNKNOWN ft. ELEVATION: UNKNOWN ft. WELL'S STATIC WATER LEVEL 7 ft. below land surface measured on mo/day/yr 05-24-93

5 TYPE OF BLANK CASING USED: 5 Wrought iron 8 Concrete tile CASING JOINTS: Glued Clamped Steel 3 RMP (SR) 6 Asbestos-Cement 9 Other (specify below) Welded PVC 4 ABS 7 Fiberglass Threaded Blank casing diameter 6 in. to TD ft., Dia. Casing height above land surface 36 in., weight HEAVY WALL lbs./ft. Wall thickness or gauge No. TYPE OF SCREEN OR PERFORATION MATERIAL: UNKNOWN 7 PVC 10 Asbestos-cement 1 Steel COULD BE 3 Stainless steel 5 Fiberglass 8 RMP (SR) 11 Other (specify) 2 Brass 4 Galvanized steel 6 Concrete tile 9 ABS 12 None used (open hole) SCREEN OR PERFORATION OPENINGS ARE: UNKNOWN 5 Gauzed wrapped 8 Saw cut 11 None (open hole) 1 Continuous slot 3 Mill slot 6 Wire wrapped 9 Drilled holes 2 Louvered shutter 4 Key punched 7 Torch cut COULD BE 10 Other (specify) SCREEN-PERFORATED INTERVALS: FROM UNKNOWN FT. TO GRAVEL PACK INTERVALS: FROM UNKNOWN FT. TO

6 GROUT MATERIAL: 1 Neat cement 2 Cement grout 3 Bentonite 4 Other Grout intervals: From 1.5 ft. to 1.8 ft. What is the nearest source of possible contamination: 1 Septic tank 4 Lateral lines 7 Pit privy 10 Livestock pens 14 Abandoned water well 2 Sewer lines 5 Cess pool 8 Sewage lagoon 11 Fuel storage 15 Oil well/Gas well 3 Watertight sewer lines 6 Seepage pit 9 Feedyard 12 Fertilizer storage 16 Other (specify below) Direction from well? AROUND IT AND ROAD 2 SIDES - How many feet? FIELD + STREAM

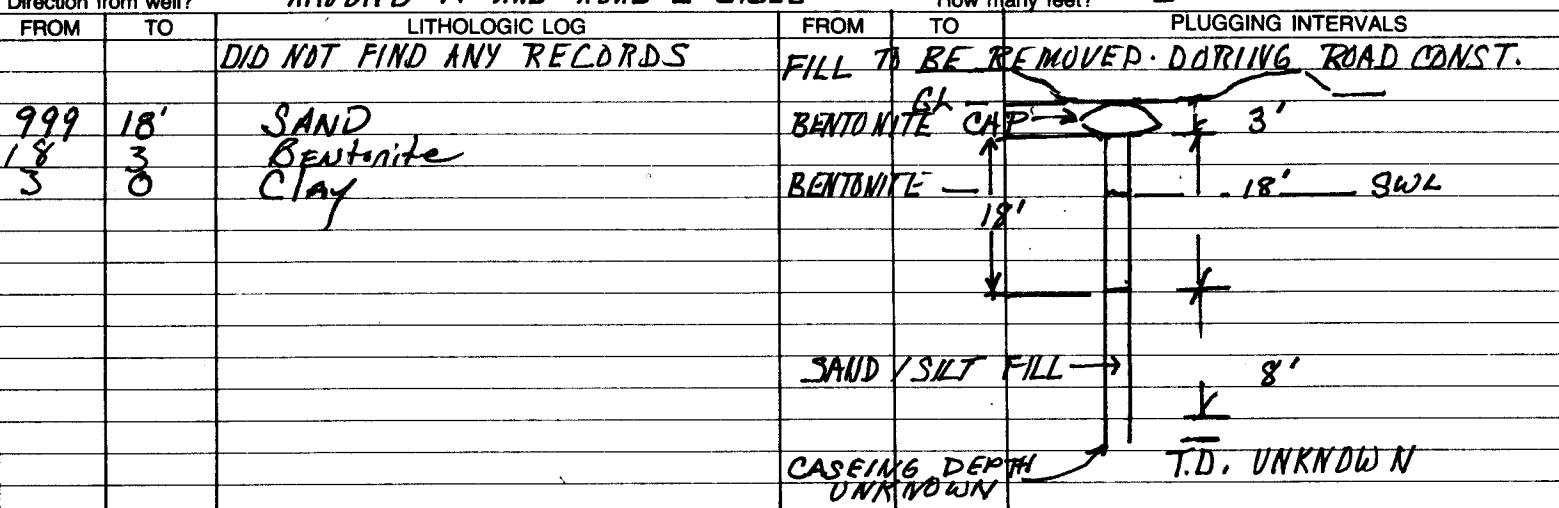

7 CONTRACTOR'S OR LANDOWNER'S CERTIFICATION: This water well was (1) constructed, (2) reconstructed, or (3) plugged under my jurisdiction and was completed on (mo/day/year) 05-24-93 and this record is true to the best of my knowledge and belief. Kansas Water Well Contractor's License No. 479 This Water Well Record was completed on (mo/day/yr) 06-05-93 under the business name of EBBERTS DRILLING by (signature) Steffen Ebberts

INSTRUCTIONS: Use typewriter or ball point pen. PLEASE PRESS FIRMLY and PRINT clearly. Please fill in blanks, underline or circle the correct answers. Send top three copies to Kansas Department of Health and Environment, Bureau of Water, Topeka, Kansas 66620-0001. Telephone: 913-296-5545. Send one to WATER WELL OWNER and retain one for your records.