USE TYPEWRITER OR BALL POINT PEN-PRESS FIRMLY, PRINT CLEARLY.

WATER WELL RECORD
KSA 82a-1201-1215

Kansas Department of Health and Environment-Division of Environment
(Water well Contractors)
Topeka, Kansas 66620

1. Location of well: County Washington; Fraction NE 1/4 NE 1/4 NE 1/4; Section number 26; Township number T 1 S; Range number R 1 E W

2. Distance and direction from nearest town or city: 1 west 6 North 1 east of Haddam
Street address of well location if in city:

3. Owner of well: Rodney Arbuthnot
R.R. or street: R.R.
City, state, zip code: Haddam, Kans. 66944

4. Locate with "X" in section below:

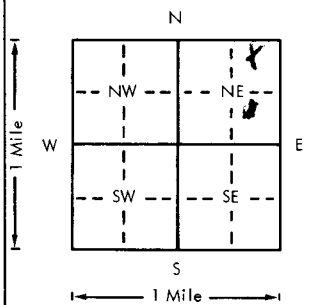

Sketch map:

6. Bore hole dia. 8 in. Completion date 9-26-79
Well depth 242 ft.

7. Cable tool X Rotary Driven Dug
Hollow rod Jetted Bored Reverse rotary

8. Use: X Domestic Public supply Industry
Irrigation Air conditioning Stock
Lawn Oil field water Other

9. Casing: Material PVC; Height: Above or below
Threaded Welded; Surface 12 in.
RMP PVC; Weight 200 lbs./ft.
Dia 5 in. to 242 ft. depth; Wall Thickness: inches or
Dia. in. to ft. depth; gage No. 200

10. Screen: Manufacturer's name Plastic NSF approved
Type Plastic Dia. 5in
Slot/gauze 10-30 Length 20
Set between 220 ft. and 240 ft.
ft. and ft.
Gravel pack? Yes Size range of material Ulgamel

11. Static water level: mo./day/yr.
157 ft. below land surface Date 1-20-79

12. Pumping level below land surfaces:
ft. after hrs. pumping g.p.m.
ft. after hrs. pumping g.p.m.
Estimated maximum yield 75+ g.p.m.

13. Water sample submitted: mo./day/yr.
Yes X No Date

14. Well head completion: capped
Pitless adapter Inches above grade

15. Well grouted? Yes
With: Neat cement Bentonite X Concrete
Depth: From 0 ft. to 20 ft.

16. Nearest source of possible contamination: none
ft. Direction Type
Well disinfected upon completion? X Yes No

17. Pump: X Not installed
Manufacturer's name
Model number HP Volts
Length of drop pipe ft. capacity g.p.m.
Type:
Submersible Turbine
Jet Reciprocating
Centrifugal Other

5. Type and color of material	From	To
soil Top	0	2
Clay Brown	2	6
Limestone + Clay Layers	6	16
shale yellow	16	30
shale Gray	30	86
shale tan	86	95
sandrock	95	124
shale Gray	124	170
shale Brown	170	175
sand Rock	175	180
limestone rock	180	182
shale Brown	182	206
sand Rock	206	242
(Use a second sheet if needed)		

18. Elevation: 1500
Topography:
Hill
Slope
Upland
Valley

19. Remarks:

20. Water well contractor's certification:
This well was drilled under my jurisdiction and this report is true to the best of my knowledge and belief.
Business name Blue Valley Drilling License No. 234D
Address Blue Rapids, Ks 66411
Signed Gerald Strader Date 2-13-79
Authorized representative

T 1 R 1 E W Sec 26 1/4 NE 1/4 NE 1/4 NE 1/4

Forward the white, blue and pink copies to the Department of Health and Environment

Form WWC-5