


1 LOCATION OF WATER WELL: County: Marshall Fraction: NE 1/4 SW 1/4 NW 1/4 Section Number: 6 Township Number: T 1 S Range Number: R 10 EW

Distance and direction from nearest town or city street address of well if located within city? mw 1

2 WATER WELL OWNER: H + H Service
 RR#, St. Address, Box #: 404 Main Board of Agriculture, Division of Water Resources
 City, State, ZIP Code: Summerfield, KS 66541 Application Number:

3 LOCATE WELL'S LOCATION WITH AN "X" IN SECTION BOX:

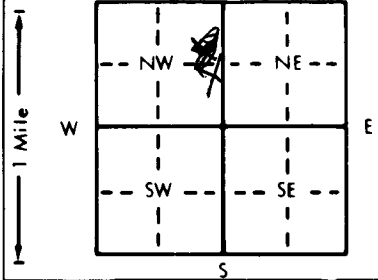

4 DEPTH OF COMPLETED WELL: 20 ft. ELEVATION:

Depth(s) Groundwater Encountered 1. 1 ft. 2. 1 ft. 3. 1 ft.
 WELL'S STATIC WATER LEVEL: 2.13 ft. below land surface measured on mo/day/yr
 Pump test data: Well water was 1 ft. after 1 hours pumping 1 gpm
 Est. Yield 1 gpm: Well water was 1 ft. after 1 hours pumping 1 gpm
 Bore Hole Diameter: 8 in. to 20 ft., and 1 in. to 1 ft.
 WELL WATER TO BE USED AS:
 1 Domestic 1 3 Feedlot 1 6 Oil field water supply 1 9 Dewatering 1 12 Other (Specify below)
 2 Irrigation 1 4 Industrial 1 7 Lawn and garden only 1 10 Monitoring well 1
 Was a chemical/bacteriological sample submitted to Department? Yes 1 No 1; If yes, mo/day/yr sample was submitted 1
 Water Well Disinfected? Yes 1 No 1

5 TYPE OF BLANK CASING USED:
 1 Steel 1 3 RMP (SR) 1 5 Wrought iron 1 8 Concrete tile 1 CASING JOINTS: Glued 1 Clamped 1
 2 PVC 1 4 ABS 1 7 Fiberglass 1 9 Other (specify below) 1 Welded 1
 Blank casing diameter: 2 in. to 5 ft., Dia 1 in. to 1 ft., Dia 1 in. to 1 ft.
 Casing height above land surface: 1 in., weight 1 lbs./ft. Wall thickness or gauge No. Sch 40

TYPE OF SCREEN OR PERFORATION MATERIAL:
 1 Steel 1 3 Stainless steel 1 5 Fiberglass 1 8 RMP (SR) 1 10 Asbestos-cement 1
 2 Brass 1 4 Galvanized steel 1 6 Concrete tile 1 9 ABS 1 11 Other (specify) 1 12 None used (open hole) 1
 SCREEN OR PERFORATION OPENINGS ARE:
 1 Continuous slot 1 3 Mill slot 1 5 Gauzed wrapped 1 8 Saw cut 1 11 None (open hole) 1
 2 Louvered shutter 1 4 Key punched 1 6 Wire wrapped 1 9 Drilled holes 1
 7 Torch cut 1 10 Other (specify) 1

SCREEN-PERFORATED INTERVALS: From 5 ft. to 20 ft., From 1 ft. to 1 ft., From 1 ft. to 1 ft.
 GRAVEL PACK INTERVALS: From 4 ft. to 20 ft., From 1 ft. to 1 ft., From 1 ft. to 1 ft.

6 GROUT MATERIAL: 1 Neat cement 1 2 Cement grout 1 3 Bentonite 1 4 Other 1
 Grout Intervals: From 0 ft. to 2 ft., From 2 ft. to 4 ft., From 1 ft. to 1 ft.
 What is the nearest source of possible contamination:
 1 Septic tank 1 4 Lateral lines 1 7 Pit privy 1 10 Livestock pens 1 14 Abandoned water well 1
 2 Sewer lines 1 5 Cess pool 1 8 Sewage lagoon 1 11 Fuel storage 1 15 Oil well/Gas well 1
 3 Watertight sewer lines 1 6 Seepage pit 1 9 Feedyard 1 12 Fertilizer storage 1 16 Other (specify below) 1
 13 Insecticide storage 1

Direction from well? How many feet?

FROM	TO	LITHOLOGIC LOG	FROM	TO	PLUGGING INTERVALS
0	4	Clay & silty			
4	9	greenish gray clay			
9	15	silt very clayey med gray			
15	20	greenish gray clay with soft caliche			

7 CONTRACTOR'S OR LANDOWNER'S CERTIFICATION: This water well was 1 constructed, (2) reconstructed, or (3) plugged under my jurisdiction and was completed on (mo/day/year) 3/4/97 and this record is true to the best of my knowledge and belief. Kansas Water Well Contractor's License No. 534C This Water Well Record was completed on (mo/day/yr) 5/22/97 under the business name of AGD SERVICES by (signature) [Signature]