

2


WATER WELL PLUGGING RECORD Form WWC-5P KSA 82a-1212 ID NO.

[Empty box for ID No.]

1 LOCATION OF WATER WELL: Fraction SW 1/4 1/4 1/4 Section Number 8 Township Number 1 Range Number 11 E/W County: NEMAH

Distance and direction from nearest town or city street address of well if located within city?

2 WATER WELL OWNER: LARRY BUESSING RR#, St. Address, Box #: 824 N 3RD City, State ZIP Code: ATOHISON, KS. 66002 Global Positioning Systems (decimal degrees, min. of 4 digits Latitude: Longitude: Elevation: Datum: Data Collection Method:

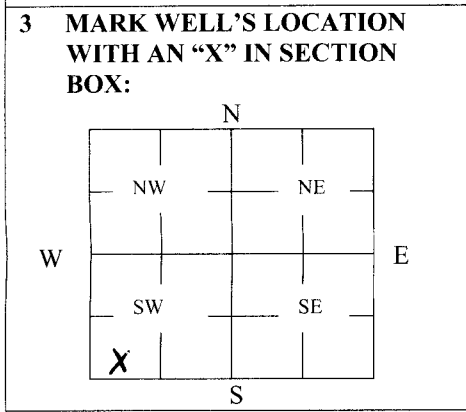

4 DEPTH OF WELL 26 ft. WELL'S STATIC WATER LEVEL 13 ft. WELL WAS USED AS: 1 Domestic 2 Irrigation 3 Feedlot 4 Industrial 5 Public Water Supply 6 Oil Field Water Supply 7 Domestic (Lawn & Garden) 8 Air Conditioning 9 Dewatering 10 Monitoring 11 Injection Well 12 Other Was a chemical/bacteriological sample submitted to Department? Yes No X

5 TYPE OF BLANK CASING USED: 1 Steel 2 PVC 3 RMP (SR) 4 ABS 5 Wrought 6 Asbestos-Cement 7 Fiberglass 8 Concrete Tile 9 Other (Specify below) ROCK LINED Blank casing diameter 24 in. Was casing pulled? Yes X No If yes, how much 6 FT. Casing height above or below land surface in.

6 GROUT PLUG MATERIAL: 1 Neat cement 2 Cement grout 3 Bentonite 4 Other Grout Plug Intervals: From ft. to ft., From ft. to ft., From to ft. What is the nearest source of possible contamination: 1 Septic tank 2 Sewer lines 3 Watertight sewer lines 4 Lateral lines 5 Cess pool 6 Seepage pit 7 Pit privy 8 Sewage lagoon 9 Feedyard 10 Livestock pens 11 Fuel Storage 12 Fertilizer storage 13 Insecticide storage 14 Abandoned water well 15 Oil well/Gas well 16 Other (specify below) Direction from well? How many feet?

Table with 6 columns: FROM, TO, PLUGGING MATERIALS, FROM, TO, PLUGGING MATERIALS. Rows contain: 26 FT 6' CHLORINATED SAND, 6 FT 5.5 FT BENTONITE, 5.5 FT 0 TOP SOIL

7 CONTRACTOR'S OR LANDOWNER'S CERTIFICATION: This water well was plugged under my jurisdiction and was completed on (mo/day/year) 6-19-09 and this record is true to the best of my knowledge and belief. Kansas Water Well Contractor's License No. This Water Well Record was completed on (mo/day/year) under the business name of by (signature) Mark Wayne

INSTRUCTIONS: Use typewriter or ballpoint pen. Please press firmly and print clearly. Please fill in blanks, underline or circle the correct answers. Send top three copies to Kansas Department of Health and Environment, Bureau of Water, Geology Section, 1000 SW Jackson St., Ste. 420, Topeka, Kansas 66612-1367. Telephone: 785/296-5522. Send one to Water Well Owner and retain one for your records. Visit us at http://www.kdheks.gov/geo/waterwells.