


1 LOCATION OF WATER WELL: Fraction NE 1/4 NE 1/4 NE 1/4 Section Number 3 Township Number T 1 S Range Number R 14 EW

Distance and direction from nearest town or city street address of well if located within city?
 4 1/2 north 3/4 east of Berwick

2 WATER WELL OWNER: Joe Wiltz
 RR#, St. Address, Box # : 110 S. 6th Board of Agriculture, Division of Water Resources
 City, State, ZIP Code : Sabetha, KS 66534 Application Number:

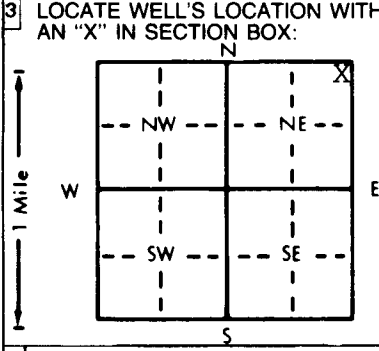

4 DEPTH OF COMPLETED WELL... 160' ft. ELEVATION:
 Depth(s) Groundwater Encountered 1... 66' ft. 2... ft. 3... ft.
 WELL'S STATIC WATER LEVEL... 50' ft. below land surface measured on mo/day/yr 11-16-95
 Pump test data: Well water was ... ft. after ... hours pumping ... gpm
 Est. Yield ... 2... gpm: Well water was ... ft. after ... hours pumping ... gpm
 Bore Hole Diameter 8 3/4 in. to ... ft., and ... in. to ... ft.
 WELL WATER TO BE USED AS: 5 Public water supply 8 Air conditioning 11 Injection well
 1 Domestic 3 Feedlot 6 Oil field water supply 9 Dewatering 12 Other (Specify below)
 2 Irrigation 4 Industrial 7 Lawn and garden only 10 Monitoring well
 Was a chemical/bacteriological sample submitted to Department? Yes... No... X...; If yes, mo/day/yr sample was submitted
 Water Well Disinfected? Yes X No

5 TYPE OF BLANK CASING USED:
 1 Steel 3 RMP (SR) 5 Wrought iron 8 Concrete tile CASING JOINTS: Glued X Clamped
 2 PVC 4 ABS 6 Asbestos-Cement 9 Other (specify below) Welded
 7 Fiberglass Threaded
 Blank casing diameter ... 5" in. to ... 0-40 ft., Dia ... 5" in. to ... 80-100 ft., Dia ... in. to ... ft.
 Casing height above land surface ... 24" in., weight ... 2.82 lbs./ft. Wall thickness or gauge No. ... 258
 TYPE OF SCREEN OR PERFORATION MATERIAL:
 1 Steel 3 Stainless steel 5 Fiberglass 7 PVC 10 Asbestos-cement
 2 Brass 4 Galvanized steel 6 Concrete tile 8 RMP (SR) 11 Other (specify)
 12 None used (open hole)
 SCREEN OR PERFORATION OPENINGS ARE:
 1 Continuous slot 3 Mill slot 5 Gauzed wrapped 8 Saw cut 11 None (open hole)
 2 Louvered shutter 4 Key punched 6 Wire wrapped 9 Drilled holes
 7 Torch cut 10 Other (specify)
 SCREEN-PERFORATED INTERVALS: From ... 40 ft. to ... 80 ft., From ... ft. to ... ft.
 From ... 100 ft. to ... 120 ft., From ... ft. to ... ft.
 GRAVEL PACK INTERVALS: From ... 24 ft. to ... 160 ft., From ... ft. to ... ft.
 From ... ft. to ... ft., From ... ft. to ... ft.

6 GROUT MATERIAL: 1 Neat cement 2 Cement grout 3 Bentonite 4 Other
 Grout Intervals: From ... 4 ft. to ... 24 ft., From ... ft. to ... ft., From ... ft. to ... ft.
 What is the nearest source of possible contamination:
 1 Septic tank 4 Lateral lines 7 Pit privy 10 Livestock pens 14 Abandoned water well
 2 Sewer lines 5 Cess pool 8 Sewage lagoon 11 Fuel storage 15 Oil well/Gas well
 3 Watertight sewer lines 6 Seepage pit 9 Feedyard 12 Fertilizer storage 16 Other (specify below)
 13 Insecticide storage XXXX POND
 Direction from well? south How many feet? 120'

FROM	TO	LITHOLOGIC LOG	FROM	TO	PLUGGING INTERVALS
0	10	Clay-Brown	108	113	Limestone-Grey
10	38	Shale-Yellow	113	118	Shale-Grey
38	41	Shale-Red	118	125	Limestone-Grey
41	43	Shale-Yellow	125	135	Shale-Grey
43	45	Limestone-Yellow	135	138	Gyp
45	61	Shale-Yellow	138	145	Shale-Black
61	66	Limestone-Y-Loose	145	148	Limestone-Grey
66	70	Limestone-Grey	148	158	Shale-Grey
70	75	Shale-Black	158	160	Gyp
75	80	Limestone-Grey			
80	82	Shale-Grey			
82	90	Limestone-Grey			
90	95	Shale-Grey			
95	97	Limestone-Grey			
97	108	Shale-Grey			

7 CONTRACTOR'S OR LANDOWNER'S CERTIFICATION: This water well was (1) constructed, (2) reconstructed, or (3) plugged under my jurisdiction and was completed on (mo/day/year) 11-16-95 and this record is true to the best of my knowledge and belief. Kansas Water Well Contractor's License No. 182 This Water Well Record was completed on (mo/day/yr) 11-28-95 under the business name of STRADER DRILLING CO., INC. by (signature) Dale Strader