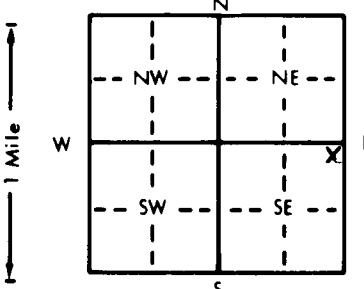


1 LOCATION OF WATER WELL: County: Nemaha Fraction NE 1/4 NE 1/4 SE 1/4 Section Number 12 Township Number T 1 S Range Number R 14 EW

Distance and direction from nearest town or city street address of well if located within city?

4 miles North of Sabetha, KS

2 WATER WELL OWNER: Rodney Bradbury
 RR#, St. Address, Box #: RR 1, Box 68A Board of Agriculture, Division of Water Resources
 City, State, ZIP Code: Morrill, KS 66515 Application Number:

3 LOCATE WELL'S LOCATION WITH AN "X" IN SECTION BOX:

 4 DEPTH OF COMPLETED WELL: 80 ft. ELEVATION:
 Depth(s) Groundwater Encountered 1. 54 ft. 2. ft. 3. ft.
 WELL'S STATIC WATER LEVEL 45 ft. below land surface measured on mo/day/yr 6-3-96
 Pump test data: Well water was 50 ft. after 1 hours pumping 25 gpm
 Est. Yield 25 gpm: Well water was ft. after hours pumping gpm
 Bore Hole Diameter 9 in. to 80 ft. and in. to ft.
 WELL WATER TO BE USED AS: 5 Public water supply 8 Air conditioning 11 Injection well
 1 Domestic 3 Feedlot 6 Oil field water supply 9 Dewatering 12 Other (Specify below)
 2 Irrigation 4 Industrial 7 Lawn and garden only 10 Monitoring well
 Was a chemical/bacteriological sample submitted to Department? Yes No X; If yes, mo/day/yr sample was submitted
 Water Well Disinfected? Yes X No

5 TYPE OF BLANK CASING USED:
 1 Steel 3 RMP (SR) 5 Wrought iron 8 Concrete tile CASING JOINTS: Glued X Clamped
 2 PVC 4 ABS 6 Asbestos-Cement 9 Other (specify below) Welded
 7 Fiberglass Threaded
 Blank casing diameter 5 in. to 50 ft. Dia in. to ft. Dia in. to ft.
 Casing height above land surface 18 in. weight 2,843 lbs./ft. Wall thickness or gauge No. SDR 21
 TYPE OF SCREEN OR PERFORATION MATERIAL:
 1 Steel 3 Stainless steel 5 Fiberglass 7 PVC 10 Asbestos-cement
 2 Brass 4 Galvanized steel 6 Concrete tile 8 RMP (SR) 11 Other (specify)
 9 ABS 12 None used (open hole)
 SCREEN OR PERFORATION OPENINGS ARE:
 1 Continuous slot 3 Mill slot 5 Gauzed wrapped 8 Saw cut 11 None (open hole)
 2 Louvered shutter 4 Key punched 6 Wire wrapped 9 Drilled holes
 7 Torch cut 10 Other (specify)
 SCREEN-PERFORATED INTERVALS: From 50 ft. to 80 ft. From ft. to ft.
 From ft. to ft. From ft. to ft.
 GRAVEL PACK INTERVALS: From 30 ft. to 80 ft. From ft. to ft.
 From ft. to ft. From ft. to ft.

6 GROUT MATERIAL: 1 Neat cement 2 Cement grout 3 Bentonite 4 Other
 Grout Intervals: From ft. to ft. From ft. to ft. From 4 ft. to 25 ft.
 What is the nearest source of possible contamination:
 1 Septic tank 4 Lateral lines 7 Pit privy 10 Livestock pens 14 Abandoned water well
 2 Sewer lines 5 Cess pool 8 Sewage lagoon 11 Fuel storage 15 Oil well/Gas well
 3 Watertight sewer lines 6 Seepage pit 9 Feedyard 12 Fertilizer storage 16 Other (specify below)
 13 Insecticide storage
 Direction from well? How many feet?

FROM	TO	LITHOLOGIC LOG	FROM	TO	PLUGGING INTERVALS (Cont.)
0	5	No Sample	54	59	lost cer.-No sample
5	8	Sahle - lt. gray	59	64	Limestone - gray
8	10	Shale - greenish gray	64	67	shale - med. gray
10	13.5	shale - red	67	69.5	limestone - gray
13.5	19	shale - lt. gray	69.5	74	shale - gray
19	22	shale-greenish gray w/ red motteling	74	76	limestone - gray
22	27.5	limestone - red	76	80	shale
27.5	34	shale - red			
34	35	limestone - lt. gray			
35	41	limestone - lt. gray			
41	41.5	shale - dk. gray			
41.5	42.5	limetone - gray			
42.5	47	shale - black			
47	50	limestone - gray			
50	54	shale - gray			

7 CONTRACTOR'S OR LANDOWNER'S CERTIFICATION: This water well was (1) constructed, (2) reconstructed, or (3) plugged under my jurisdiction and was completed on (mo/day/year) 6-3-96 and this record is true to the best of my knowledge and belief. Kansas Water Well Contractor's License No. 308 This Water Well Record was completed on (mo/day/yr) 6-15-96 under the business name of Rieschick Drilling Co. by (signature) *Roy Rieschick*