


1 LOCATION OF WATER WELL: Fraction SW 1/4 SW 1/4 SE 1/4 Section Number 25 Township Number T 1 S Range Number R 14 E/W
 County: Brown

Distance and direction from nearest town or city street address of well if located within city?
 1/2 mile north of Sabetha, KS

2 WATER WELL OWNER: Curtis Deckinger
 RR#, St. Address, Box #: Rt. 3, Box 35A Board of Agriculture, Division of Water Resources
 City, State, ZIP Code: Sabetha, KS 66534 Application Number:

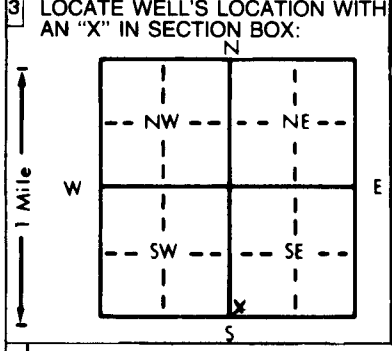

4 DEPTH OF COMPLETED WELL: 100' ft. ELEVATION:
 Depth(s) Groundwater Encountered 1. 43 ft. 2. ft. 3. ft.
 WELL'S STATIC WATER LEVEL: 25 ft. below land surface measured on mo/day/yr 8-29-97
 Pump test data: Well water was ft. after hours pumping gpm
 Est. Yield 3-4 gpm: Well water was ft. after hours pumping gpm
 Bore Hole Diameter: 9 1/2 in. to 100 ft. and in. to ft.
 WELL WATER TO BE USED AS:
 1 Domestic 3 Feedlot 6 Oil field water supply 9 Dewatering 12 Other (Specify below)
 2 Irrigation 4 Industrial 7 Lawn and garden only 10 Monitoring well
 Was a chemical/bacteriological sample submitted to Department? Yes.....No.....X.....; If yes, mo/day/yr sample was submitted
 Water Well Disinfected? Yes X No

5 TYPE OF BLANK CASING USED:
 1 Steel 3 RMP (SR) 6 Asbestos-Cement 9 Other (specify below) Welded
 2 PVC 4 ABS 7 Fiberglass Threaded
 Blank casing diameter 5" in. to 25 ft. Dia. in. to ft. Dia. in. to ft.
 Casing height above land surface 20 in., weight 265 lbs./ft. Wall thickness or gauge No. SDR 21
 TYPE OF SCREEN OR PERFORATION MATERIAL:
 1 Steel 3 Stainless steel 5 Fiberglass 7 PVC 10 Asbestos-cement
 2 Brass 4 Galvanized steel 6 Concrete tile 8 RMP (SR) 11 Other (specify)
 SCREEN OR PERFORATION OPENINGS ARE:
 1 Continuous slot 3 Mill slot 4 Gauzed wrapped 8 Saw cut 11 None (open hole)
 2 Louvered shutter 4 Key punched 6 Wire wrapped 9 Drilled holes
 7 Torch cut 10 Other (specify)
 SCREEN-PERFORATED INTERVALS: From 25 ft. to 100 ft., From ft. to ft.
 GRAVEL PACK INTERVALS: From 24 ft. to 100 ft., From ft. to ft.

6 GROUT MATERIAL: 1 Neat cement 2 Cement grout 3 Bentonite 4 Other
 Grout Intervals: From 2 ft. to 24 ft., From ft. to ft., From ft. to ft.
 What is the nearest source of possible contamination:
 1 Septic tank 4 Lateral lines 7 Pit privy 10 Livestock pens 14 Abandoned water well
 2 Sewer lines 5 Cess pool 8 Sewage lagoon 11 Fuel storage 15 Oil well/Gas well
 3 Watertight sewer lines 6 Seepage pit 9 Feedyard 12 Fertilizer storage 16 Other (specify below)
 13 Insecticide storage NONE

Direction from well? How many feet?

FROM	TO	LITHOLOGIC LOG	FROM	TO	PLUGGING INTERVALS
0	5	No Sample	48	50	shale - greenish gray
5	7	Clay - brn	50	53	shale - red
7	16	shale - yellow brn	53	54	shale - greenish gray
16	17	limestone - yel. brn.	54	60	shale - red
17	18	shale - yel. brn.	60	61	shale - greenish gray
18	22	limestone - brownish gray	61	65.5	gypsan
22	26	shale - brn. gray	65.5	72	limestone - gray
26	32	shale - greenish gray	72	73	shale - dk. gray
32	35	shale - gray	73	74	limestone - gray
35	39	shale - greenish gray	74	80	shale - dk. gray
39	42	shale - red	80	81.5	limestone - gray
42	43	shale - gray	81.5	85	shale - gray
43	46	limestone - gray	85	87	shale - greenish gray
46	47	shale - greenish gray	87	94	gypsan
47	48	shale - red	94	98	limestone - blackish gray

7 CONTRACTOR'S OR LANDOWNER'S CERTIFICATION: This water well was (1) constructed, (2) reconstructed, or (3) plugged under my jurisdiction and was completed on (mo/day/year) 8-29-97 and this record is true to the best of my knowledge and belief. Kansas Water Well Contractor's License No. 308 This Water Well Record was completed on (mo/day/yr) 9-9-97 under the business name of Rieschick Drilling Company by (signature) *Rieschick*