

**WATER WELL PLUGGING RECORD Form WWC-5P**


KSA 82a-1212 ID NO.  

<b>1 LOCATION OF WATER WELL:</b> County: <u>Nemaha</u>	Fraction <u>SE</u> <u>1/4</u> 1/4 1/4	Section Number <u>1</u>	Township Number <u>T-1-S</u>	Range Number <u>R-14-E E/W</u>
---	--	-------------------------	------------------------------	--------------------------------

Distance and direction from nearest town or city street address of well if located within city?

5 1/4 miles north of Sabetha, Ks. on US-75

<b>2 WATER WELL OWNER:</b> <u>KDOT</u> RR#, St. Address, Box #: <u>801 North 11th St.</u> City, State ZIP Code: <u>Seneca, Ks. 66538</u>	<b>Global Positioning Systems</b> (decimal degrees, min. of 4 digits) Latitude: _____ Longitude: _____ Elevation: _____ Datum: _____ Data Collection Method: _____
---	---

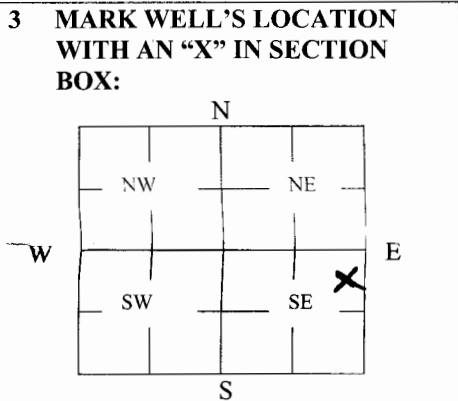

**4 DEPTH OF WELL** 75' ft.

WELL'S STATIC WATER LEVEL 10' ft

WELL WAS USED AS: water supply well for office of Ks. Port of Entry (since removed years ago)

1 Domestic	<u>5</u> Public Water Supply	9 Dewatering
2 Irrigation	6 Oil Field Water Supply	10 Monitoring
3 Feedlot	7 Domestic (Lawn & Garden)	11 Injection Well
4 Industrial	8 Air Conditioning	12 Other _____

Was a chemical/bacteriological sample submitted to Department? Yes  No

**5 TYPE OF BLANK CASING USED:**

1 Steel	3 RMP (SR)	5 Wrought	7 Fiberglass	9 Other (Specify below)
<u>2 PVC</u>	4 ABS	6 Asbestos-Cement	8 Concrete Tile	_____

Blank casing diameter 6 in. Was casing pulled? Yes  No  If yes, how much top 8'

Casing height above or below 84" and surface \_\_\_\_\_ in.

**6 GROUT PLUG MATERIAL:** 1 Neat cement 2 Cement grout 3 Bentonite 4 Other \_\_\_\_\_

Grout Plug Intervals: From 6 ft. to 8 ft., From \_\_\_\_\_ ft. to \_\_\_\_\_ ft., From \_\_\_\_\_ to \_\_\_\_\_ ft.

What is the nearest source of possible contamination:

1 Septic tank	6 Seepage pit	11 Fuel Storage	16 Other (specify below)
2 Sewer lines	7 Pit privy	12 Fertilizer storage	_____
3 Watertight sewer lines	8 Sewage lagoon	13 Insecticide storage	_____
4 Lateral lines	9 Feedyard	14 Abandoned water well	Direction from well? <u>SE</u>
5 Cess pool	<u>10 Livestock pens</u>	15 Oil well/Gas well	How many feet? <u>1/2 mile</u>

FROM	TO	PLUGGING MATERIALS	FROM	TO	PLUGGING MATERIALS
<u>0</u>	<u>6'</u>	<u>dirt fill</u>			
<u>6'</u>	<u>8'</u>	<u>bentonite plug</u>			
<u>8'</u>	<u>75'</u>	<u>clean sand</u>			

**7 CONTRACTOR'S OR LANDOWNER'S CERTIFICATION:** This water well was plugged under my jurisdiction and was completed on (mo/day/year) 10/19/2006 and this record is true to the best of my knowledge and belief. Kansas Water Well Contractor's License No. \_\_\_\_\_. This Water Well Record was completed on (mo/day/year) 10/19/2006 under the business name of Duane F. Rader by (signature)

**INSTRUCTIONS:** Use typewriter or ballpoint pen. Please press firmly and print clearly. Please fill in blanks, underline or circle the correct answers. Send top three copies to Kansas Department of Health and Environment, Bureau of Water, Geology Section, 1000 SW Jackson St., Ste. 420, Topeka, Kansas 66612-1367. Telephone: 785/296-5522. Send one to Water Well Owner and retain one for your records. Visit us at <http://www.kdheks.gov/geo/waterwells>.