


1 LOCATION OF WATER WELL: County: Nemaha Fraction: SE 1/4 SE 1/4 SE 1/4 Section Number: 14 Township Number: T 1 S Range Number: R 14 EW

Distance and direction from nearest town or city street address of well if located within city?  
4 1/4 miles North of Sabetta

2 WATER WELL OWNER: Fred Schneider  
 RR#, St. Address, Box #: SABETTA, KS 66534 Board of Agriculture, Division of Water Resources  
 City, State, ZIP Code: SABETTA, KS 66534 Application Number:

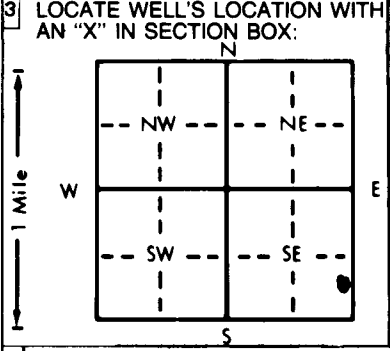

4 DEPTH OF COMPLETED WELL: 66 ft. ELEVATION: .....  
 Depth(s) Groundwater Encountered 1. 50 ft. 2. .... ft. 3. .... ft.  
 WELL'S STATIC WATER LEVEL 30 ft. below land surface measured on mo/day/yr 5-3-89  
 Pump test data: Well water was ..... ft. after ..... hours pumping ..... gpm  
 Est. Yield 25 gpm: Well water was ..... ft. after ..... hours pumping ..... gpm  
 Bore Hole Diameter 10 in. to 15 ft., and 7 1/2 in. to 66 ft.  
 WELL WATER TO BE USED AS:  
 1 Domestic 3 Feedlot 6 Oil field water supply 9 Dewatering 12 Other (Specify below)  
 2 Irrigation 4 Industrial 7 Lawn and garden only 10 Observation well  
 Was a chemical/bacteriological sample submitted to Department? Yes.....No.....; If yes, mo/day/yr sample was submitted  
 Water Well Disinfected? Yes  No

5 TYPE OF BLANK CASING USED:  
 1 Steel 3 RMP (SR) 5 Wrought iron 8 Concrete tile CASING JOINTS: Glued  Clamped .....  
 2 PVC 4 ABS 6 Asbestos-Cement 9 Other (specify below) Welded .....  
 7 Fiberglass Threaded .....  
 Blank casing diameter 6 in. to 66 ft., Dia. .... in. to ..... ft., Dia. .... in. to ..... ft.  
 Casing height above land surface 18 in., weight ..... lbs./ft. Wall thickness or gauge No. 0.332

TYPE OF SCREEN OR PERFORATION MATERIAL:  
 1 Steel 3 Stainless steel 5 Fiberglass 8 RMP (SR) 10 Asbestos-cement  
 2 Brass 4 Galvanized steel 6 Concrete tile 9 ABS 11 Other (specify) .....  
 12 None used (open hole)

SCREEN OR PERFORATION OPENINGS ARE:  
 1 Continuous slot 3 Mill slot 5 Gauzed wrapped 8 Saw cut 11 None (open hole)  
 2 Louvered shutter 4 Key punched 6 Wire wrapped 9 Drilled holes  
 7 Torch cut 10 Other (specify) .....

SCREEN-PERFORATED INTERVALS: From 50 ft. to 66 ft., From ..... ft. to ..... ft.  
 From ..... ft. to ..... ft., From ..... ft. to ..... ft.  
 GRAVEL PACK INTERVALS: From 15 ft. to 66 ft., From ..... ft. to ..... ft.  
 From ..... ft. to ..... ft., From ..... ft. to ..... ft.

6 GROUT MATERIAL: 1 Neat cement 2 Cement grout 3 Bentonite 4 Other .....  
 Grout Intervals: From 4 ft. to 15 ft., From ..... ft. to ..... ft., From ..... ft. to ..... ft.  
 What is the nearest source of possible contamination:  
 1 Septic tank 4 Lateral lines 7 Pit privy 10 Livestock pens 14 Abandoned water well  
 2 Sewer lines 5 Cess pool 8 Sewage lagoon 11 Fuel storage 15 Oil well/Gas well  
 3 Watertight sewer lines 6 Seepage pit 9 Feedyard 12 Fertilizer storage 16 Other (specify below) UNKNOWN  
 13 Insecticide storage

Direction from well? How many feet?

FROM	TO	LITHOLOGIC LOG	FROM	TO	LITHOLOGIC LOG
0	10	TOP SOIL			
10	17	BROWN CLAY			
17	30	LIMESTONE			
30	43	GREY CLAY			
43	46	RED CLAY			
46	50	LOOSE ROCK			
50	58	LIMESTONE			
58	65	RED CLAY			
65	66	LIMESTONE			

7 CONTRACTOR'S OR LANDOWNER'S CERTIFICATION: This water well was (1) constructed, (2) reconstructed, or (3) plugged under my jurisdiction and was completed on (mo/day/year) 5-4-89 and this record is true to the best of my knowledge and belief. Kansas Water Well Contractor's License No. 317 This Water Well Record was completed on (mo/day/yr) 6-23-89 under the business name of Williamson Well Drilling by (signature) Francis Williamson