


1] LOCATION OF WATER WELL: County: **NEMAHA** Fraction: **SE 1/4 NE 1/4 SW 1/4** Section Number: **26** Township Number: **T 1 S** Range Number: **R 14 E/W**

Distance and direction from nearest town or city street address of well if located within city?
1 1/2 north, 1 west of Sabetha

2] WATER WELL OWNER: **Alan Meyer**
 RR#, St. Address, Box # : **Rt. 3 Box 111** Board of Agriculture, Division of Water Resources
 City, State, ZIP Code : **Sabetha, KS 66534** Application Number:

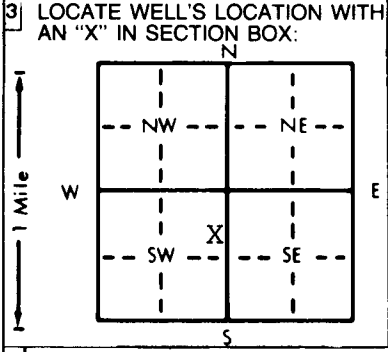

4] DEPTH OF COMPLETED WELL: **160'** ft. ELEVATION:
 Depth(s) Groundwater Encountered 1. **135-137** ft. 2. ft. 3. ft.
 WELL'S STATIC WATER LEVEL **123'-7"** ft. below land surface measured on mo/day/yr **6-03-92**
 Pump test data: Well water was ft. after hours pumping gpm
 Est. Yield **6** gpm: Well water was ft. after hours pumping gpm
 Bore Hole Diameter **8 3/4** in. to ft., and in. to ft.
 WELL WATER TO BE USED AS:
 5 Public water supply 8 Air conditioning 11 Injection well
 1 Domestic 3 Feedlot 6 Oil field water supply 9 Dewatering 12 Other (Specify below)
 2 Irrigation 4 Industrial 7 Lawn and garden only 10 Monitoring well
 Was a chemical/bacteriological sample submitted to Department? Yes No **X**; If yes, mo/day/yr sample was submitted
 Water Well Disinfected? Yes **X** No

5] TYPE OF BLANK CASING USED:
 1 Steel 3 RMP (SR) 5 Wrought iron 8 Concrete tile CASING JOINTS: Glued **X** Clamped
 2 PVC 4 ABS 6 Asbestos-Cement 9 Other (specify below) Welded
 7 Fiberglass Threaded
 Blank casing diameter **5"** in. to **0-110** ft. Dia. in. to ft. Dia. in. to ft.
 Casing height above land surface **24"** in. weight **2.82** lbs./ft. Wall thickness or gauge No. **.258**
 TYPE OF SCREEN OR PERFORATION MATERIAL:
 1 Steel 3 Stainless steel 5 Fiberglass 7 PVC 10 Asbestos-cement
 2 Brass 4 Galvanized steel 6 Concrete tile 8 RMP (SR) 11 Other (specify)
 12 None used (open hole)
 SCREEN OR PERFORATION OPENINGS ARE:
 1 Continuous slot 3 Mill slot 5 Gauzed wrapped 8 Saw cut 11 None (open hole)
 2 Louvered shutter 4 Key punched 6 Wire wrapped 9 Drilled holes
 7 Torch cut 10 Other (specify)
 SCREEN-PERFORATED INTERVALS: From **110** ft. to **160** ft., From ft. to ft.
 From ft. to ft., From ft. to ft.
 GRAVEL PACK INTERVALS: From **24** ft. to **160'** ft., From ft. to ft.
 From ft. to ft., From ft. to ft.

6] GROUT MATERIAL: 1 Neat cement 2 Cement grout 3 Bentonite 4 Other
 Grout Intervals: From **4** ft. to **24** ft., From ft. to ft., From ft. to ft.
 What is the nearest source of possible contamination:
 1 Septic tank 4 Lateral lines 7 Pit privy 10 Livestock pens 14 Abandoned water well
 2 Sewer lines 5 Cess pool 8 Sewage lagoon 11 Fuel storage 15 Oil well/Gas well
 3 Watertight sewer lines 6 Seepage pit 9 Feedyard 12 Fertilizer storage 16 Other (specify below)
 13 Insecticide storage
 Direction from well? **north** How many feet? **135'**

FROM	TO	LITHOLOGIC LOG	FROM	TO	PLUGGING INTERVALS
0	1	Top Soil	93	97	Limestone-Grey
1	25	Clay-Brown	97	109	Shale-Grey
25	26	Boulders	109	124	Shaley Limestone-Grey
26	31	Clay-Brown	124-136		Shale-Grey
31	32	Fine Sand-Brown	137	138	Limestone-Yellow 6 GPM
32	X 51	Clay-Brown	138	160	Shaley Limestone-Grey
51	58	Shale-Yellow			
58	59	Shale-Red			
59	63	Shale-Yellow			
63	67	LS-Yellow lost circulation			
67	70	Shale-Yellow			
70	75	Shale-Grey			
75	76	Limestone-Grey			
76	90	Shale-Grey			
90	93	Shale-Yellow			

7] CONTRACTOR'S OR LANDOWNER'S CERTIFICATION: This water well was (1) constructed, (2) reconstructed, or (3) plugged under my jurisdiction and was completed on (mo/day/year) **6-03-92** and this record is true to the best of my knowledge and belief. Kansas Water Well Contractor's License No. **182**. This Water Well Record was completed on (mo/day/yr) **7-9-92** under the business name of **STRADER DRILLING CO., INC.** by (signature) *[Signature]*