


1 LOCATION OF WATER WELL: County: Neosho Fraction: SE 1/4 Section Number: 26 Township Number: T 1 S Range Number: R 14 E/W

Distance and direction from nearest town or city street address of well if located within city?
1 mile North of SAbETHA

2 WATER WELL OWNER: ROONEY STRAHM
 RR#, St. Address, Box #: SABETHA, KS 66534
 City, State, ZIP Code: SABETHA, KS 66534
 Board of Agriculture, Division of Water Resources
 Application Number:

3 LOCATE WELL'S LOCATION WITH AN "X" IN SECTION BOX:

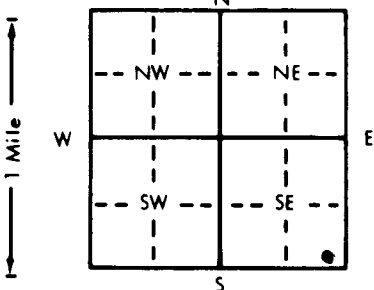

4 DEPTH OF COMPLETED WELL: 83 ft. ELEVATION: 40 ft.

Depth(s) Groundwater Encountered 1. 53 ft. 2. 40 ft. 3. 4-18-90 ft.
 WELL'S STATIC WATER LEVEL 53 ft. below land surface measured on mo/day/yr 4-18-90
 Pump test data: Well water was _____ ft. after _____ hours pumping _____ gpm
 Est. Yield 10 gpm: Well water was _____ ft. after _____ hours pumping _____ gpm
 Bore Hole Diameter 10 in. to 15 ft., and 7 1/2 in. to 83 ft.
 WELL WATER TO BE USED AS:
 1 Domestic 1 3 Feedlot 3 6 Oil field water supply 6 9 Dewatering 9 12 Other (Specify below)
 2 Irrigation 2 4 Industrial 4 7 Lawn and garden only 7 10 Monitoring well 10
 Was a chemical/bacteriological sample submitted to Department? Yes _____ No ✓; If yes, mo/day/yr sample was submitted _____
 Water Well Disinfected? Yes ✓ No _____

5 TYPE OF BLANK CASING USED:
 1 Steel 2 3 RMP (SR) 3 5 Wrought iron 5 8 Concrete tile 8 CASING JOINTS: Glued ✓ Clamped _____
 2 PVC 2 4 ABS 4 6 Asbestos-Cement 6 9 Other (specify below) _____ Welded _____
 7 Fiberglass 7 Threaded _____

Blank casing diameter 6 in. to 83 ft., Dia _____ in. to _____ ft., Dia _____ in. to _____ ft.
 Casing height above land surface 18 in., weight _____ lbs./ft. Wall thickness or gauge No. 0.332

TYPE OF SCREEN OR PERFORATION MATERIAL:
 1 Steel 7 3 Stainless steel 3 5 Fiberglass 5 8 RMP (SR) 8 10 Asbestos-cement 10
 2 Brass 2 4 Galvanized steel 4 6 Concrete tile 6 9 ABS 9 11 Other (specify) _____
 12 None used (open hole) _____

SCREEN OR PERFORATION OPENINGS ARE:
 1 Continuous slot 8 3 Mill slot 3 5 Gauzed wrapped 5 8 Saw cut 8 11 None (open hole) _____
 2 Louvered shutter 2 4 Key punched 4 6 Wire wrapped 6 9 Drilled holes 9
 7 Torch cut 7 10 Other (specify) _____

SCREEN-PERFORATED INTERVALS: From 68 ft. to 83 ft., From _____ ft. to _____ ft.
 From _____ ft. to _____ ft., From _____ ft. to _____ ft.
 GRAVEL PACK INTERVALS: From 15 ft. to 83 ft., From _____ ft. to _____ ft.
 From _____ ft. to _____ ft., From _____ ft. to _____ ft.

6 GROUT MATERIAL: 1 Neat cement 4 2 Cement grout 15 3 Bentonite 3 4 Other _____
 Grout Intervals: From 4 ft. to 15 ft., From _____ ft. to _____ ft., From _____ ft. to _____ ft.

What is the nearest source of possible contamination:
 1 Septic tank 4 4 Lateral lines 4 7 Pit privy 7 10 Livestock pens 10 14 Abandoned water well _____
 2 Sewer lines 2 5 Cess pool 5 8 Sewage lagoon 8 11 Fuel storage 11 15 Oil well/Gas well _____
 3 Watertight sewer lines 3 6 Seepage pit 6 9 Feedyard 9 12 Fertilizer storage 12 16 Other (specify below) _____
 13 Insecticide storage _____

Direction from well? South How many feet? 400

FROM	TO	LITHOLOGIC LOG	FROM	TO	PLUGGING INTERVALS
0	4	TOP SOIL			
4	15	BROWN CLAY			
15	21	GRAY CLAY			
21	29	LIME STONE			
29	37	BLUE SHALE			
37	41	GRAY SHALE			
41	46	RED CLAY			
46	50	GRAY CLAY			
50	70	LIME STONE			
70	71	HARD SHALE			
71	83	SHALE			

7 CONTRACTOR'S OR LANDOWNER'S CERTIFICATION: This water well was (1) constructed, (2) reconstructed, or (3) plugged under my jurisdiction and was completed on (mo/day/year) 4-18-90 and this record is true to the best of my knowledge and belief. Kansas Water Well Contractor's License No. 317 This Water Well Record was completed on (mo/day/yr) 6-9-90 under the business name of WILLIAMSON Well DRIG by (signature) James Williamson