


1 LOCATION OF WATER WELL: County: Nemaha Fraction: SW 1/4 SW 1/4 SW 1/4 Section Number: 36 Township Number: 1T S Range Number: R 14 (E/W)

Distance and direction from nearest town or city street address of well if located within city?
NORTH WEST EDGE OF SABETHA, KS

2 WATER WELL OWNER: MIKE KLEPPER
RR#, St. Address, Box #: SABETHA, KS 66534
City, State, ZIP Code: SABETHA, KS 66534
Board of Agriculture, Division of Water Resources
Application Number:

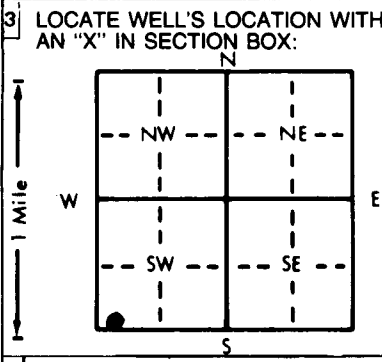

4 DEPTH OF COMPLETED WELL: 117 ft. ELEVATION:
Depth(s) Groundwater Encountered 1. 102 ft. 2. ft. 3. ft.
WELL'S STATIC WATER LEVEL: 81 ft. below land surface measured on mo/day/yr 12-20-88
Pump test data: Well water was ft. after hours pumping gpm
Est. Yield 15 gpm: Well water was ft. after hours pumping gpm
Bore Hole Diameter: 10 in. to 15 ft., and 7 1/2 in. to 117 ft.
WELL WATER TO BE USED AS:
1 Domestic 3 Feedlot 6 Oil field water supply 9 Dewatering 11 Injection well
2 Irrigation 4 Industrial 7 Lawn and garden only 10 Observation well 12 Other (Specify below)
Was a chemical/bacteriological sample submitted to Department? Yes.....No ; If yes, mo/day/yr sample was submitted
Water Well Disinfected? Yes No

5 TYPE OF BLANK CASING USED:
1 Steel 3 RMP (SR) 5 Wrought iron 8 Concrete tile CASING JOINTS: Glued Clamped
2 PVC 4 ABS 6 Asbestos-Cement 9 Other (specify below) Welded
Blank casing diameter: 6 in. to 117 ft., Dia. in. to ft., Dia. in. to ft.
Casing height above land surface: 18 in., weight lbs./ft. Wall thickness or gauge No. 0.332
TYPE OF SCREEN OR PERFORATION MATERIAL:
1 Steel 3 Stainless steel 5 Fiberglass 8 RMP (SR) 10 Asbestos-cement
2 Brass 4 Galvanized steel 6 Concrete tile 9 ABS 11 Other (specify)
12 None used (open hole)
SCREEN OR PERFORATION OPENINGS ARE:
1 Continuous slot 3 Mill slot 5 Gauzed wrapped 8 Saw cut 11 None (open hole)
2 Louvered shutter 4 Key punched 6 Wire wrapped 9 Drilled holes
7 Torch cut 10 Other (specify)
SCREEN-PERFORATED INTERVALS: From 97 ft. to 117 ft., From ft. to ft.
GRAVEL PACK INTERVALS: From 15 ft. to 117 ft., From ft. to ft.

6 GROUT MATERIAL: 1 Neat cement 2 Cement grout 3 Bentonite 4 Other
Grout Intervals: From 5 ft. to 15 ft., From ft. to ft., From ft. to ft.
What is the nearest source of possible contamination:
1 Septic tank 4 Lateral lines 7 Pit privy 11 Fuel storage 14 Abandoned water well
2 Sewer lines 5 Cess pool 8 Sewage lagoon 12 Fertilizer storage 15 Oil well/Gas well
3 Watertight sewer lines 6 Seepage pit 9 Feedyard 13 Insecticide storage 16 Other (specify below) UNKNOWN

Direction from well? How many feet?

FROM	TO	LITHOLOGIC LOG	FROM	TO	LITHOLOGIC LOG
0	13	TOP SOIL			
13	22	YELLOW CLAY			
22	50	SANDY YELLOW			
50	58	LIMESTONE			
58	69	RED CLAY			
69	79	LIMESTONE			
79	83	RED CLAY			
83	86	LIMESTONE			
86	96	GRAY SHALE			
96	102	LIMESTONE			
102	117	GRAY SHALE			

7 CONTRACTOR'S OR LANDOWNER'S CERTIFICATION: This water well was (1) constructed, (2) reconstructed, or (3) plugged under my jurisdiction and was completed on (mo/day/year) 12-20-88 and this record is true to the best of my knowledge and belief. Kansas Water Well Contractor's License No. 317. This Water Well Record was completed on (mo/day/yr) 1-28-89 under the business name of Williamson Well DRIG by (signature) Frances Williamson