


1 LOCATION OF WATER WELL: Fraction SW 1/4 NW 1/4 N9 1/4 Section Number 36 Township Number T 1 S Range Number R 14 E
 County: Nemaha

Distance and direction from nearest town or city street address of well if located within city?
1 mi north Sabetha, KS

2 WATER WELL OWNER: ~~Kevin Montgomery~~ Kevin Montgomery
 RR#, St. Address, Box #: ~~RT 1~~
 City, State, ZIP Code: Sabetha, KS 66534 Board of Agriculture, Division of Water Resources
 Application Number:

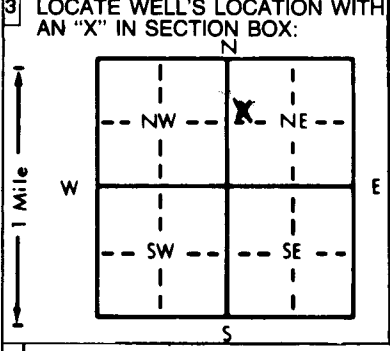

4 DEPTH OF COMPLETED WELL: 100 ft. ELEVATION:
 Depth(s) Groundwater Encountered 1. 75' ft. 2. ft. 3. ft.
 WELL'S STATIC WATER LEVEL 74 ft. below land surface measured on mo/day/yr 1-17-90
 Pump test data: Well water was ft. after hours pumping gpm
 Est. Yield 2.5 gpm: Well water was ft. after hours pumping gpm
 Bore Hole Diameter 8 in. to 10.0 ft., and in. to ft.
 WELL WATER TO BE USED AS:
 5 Public water supply 8 Air conditioning 11 Injection well
 ① Domestic 3 Feedlot 6 Oil field water supply 9 Dewatering 12 Other (Specify below) pasture
 2 Irrigation 4 Industrial 7 Lawn and garden only 10 Observation well
 Was a chemical/bacteriological sample submitted to Department? Yes No X; If yes, mo/day/yr sample was submitted
 Water Well Disinfected? Yes X No

5 TYPE OF BLANK CASING USED:
 1 Steel 3 RMP (SR) 5 Wrought iron 8 Concrete tile CASING JOINTS: Glued X Clamped
 ② PVC 4 ABS 6 Asbestos-Cement 9 Other (specify below) Welded
 7 Fiberglass Threaded
 Blank casing diameter 5" in. to 6.0 ft., Dia. 5" in. to 80-100 ft., Dia. in. to ft.
 Casing height above land surface 18 in., weight 2.843 lbs./ft. Wall thickness or gauge No. 200 PSI
 TYPE OF SCREEN OR PERFORATION MATERIAL:
 1 Steel 3 Stainless steel 5 Fiberglass 8 RMP (SR) 10 Asbestos-cement 11 Other (specify)
 2 Brass 4 Galvanized steel 6 Concrete tile 9 ABS 12 None used (open hole)
 SCREEN OR PERFORATION OPENINGS ARE:
 1 Continuous slot 3 Mill slot 5 Gauzed wrapped 8 Saw cut 11 None (open hole)
 2 Louvered shutter 4 Key punched 6 Wire wrapped 9 Drilled holes
 7 Torch cut 10 Other (specify)
 SCREEN-PERFORATED INTERVALS: From 6.0 ft. to 8.0 ft., From ft. to ft.
 From ft. to ft., From ft. to ft.
 GRAVEL PACK INTERVALS: From 3.5 ft. to 100 ft., From ft. to ft.
 From ft. to ft., From ft. to ft.

6 GROUT MATERIAL: ① Neat cement 2 Cement grout 3 Bentonite 4 Other
 Grout Intervals: From 0 ft. to 1.5 ft., From ft. to ft., From ft. to ft.
 What is the nearest source of possible contamination:
 1 Septic tank 4 Lateral lines 7 Pit privy 10 Livestock pens 14 Abandoned water well
 2 Sewer lines 5 Cess pool 8 Sewage lagoon 11 Fuel storage 15 Oil well/Gas well
 3 Watertight sewer lines 6 Seepage pit 9 Feedyard 12 Fertilizer storage 16 Other (specify below)
 13 Insecticide storage NONE KNOWN

Direction from well? How many feet?

FROM	TO	LITHOLOGIC LOG	FROM	TO	LITHOLOGIC LOG
0	4	MS	37	41	shale LGRAY
4	13	Sandy clay BR	41	44.3	shale Red
13	14.5	LS BR	44.3	54.8	shale GRAY
14.5	18	shale olive	54.8	56	LS LGRAY
18	19	shale GRAY	56	62	shale GRAY
19	21.5	shale Red	62	66.5	shale Red
21.5	22.3	shale greenish GRAY	66.5	72.5	shale LGRAY
22.3	25.5	shale Red	72.5	76.5	LS LGRAY
25.5	29.5	shale greenish GRAY	76.5	84.6	shale med GRAY
29.5	31.8	LS BR	84.6	86.8	LS GRAY
31.8	32.9	LS LGRAY	86.8	93.4	shale greenish GRAY
32.9	34	shale BR	93.4	95.1	shale LGRAY
34	34.6	LS LGRAY	95.1	100	shale med GRAY
34.6	35.5	shale L BROWN			
35.5	37	olive			

7 CONTRACTOR'S OR LANDOWNER'S CERTIFICATION: This water well was ① constructed, ② reconstructed, or ③ plugged under my jurisdiction and was completed on (mo/day/year) 1-17-90 and this record is true to the best of my knowledge and belief. Kansas Water Well Contractor's License No. 308 This Water Well Record was completed on (mo/day/yr) 1-17-90 under the business name of Rieschick Drilling Co by (signature) Ray Burch

INSTRUCTIONS: Use typewriter or ball point pen. PLEASE PRESS FIRMLY and PRINT clearly. Please fill in blanks, underline or circle the correct answers. Send top three copies to Kansas Department of Health and Environment, Bureau of Water Protection, Topeka, Kansas 66620-7320, Telephone: 913-862-9360. Send one to WATER WELL OWNER and retain one for your records.