


WATER WELL RECORD Form WWC-5 KSA 82a-1212

1 LOCATION OF WATER WELL: County: BROWN Fraction: NW 1/4 NW 1/4 SW 1/4 Section Number: 30 Township Number: T 1 S Range Number: R 15 E

Distance and direction from nearest town or city street address of well if located within city? 2 1/2 N of Sabetha

2 WATER WELL OWNER: Jerry Ketter  
 RR#, St. Address, Box #: Rt 1  
 City, State, ZIP Code: Sabetha, 66534  
 Board of Agriculture, Division of Water Resources  
 Application Number:

3 LOCATE WELL'S LOCATION WITH AN "X" IN SECTION BOX:

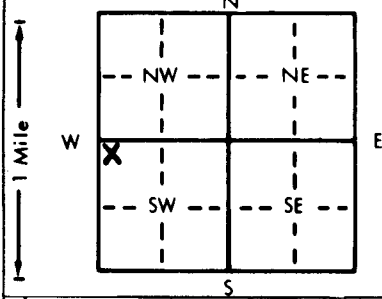

4 DEPTH OF COMPLETED WELL: 70 ft. ELEVATION:  
 Depth(s) Groundwater Encountered 1. 32 ft. 2. 10 ft. 3. 7-16-84 ft.  
 WELL'S STATIC WATER LEVEL 10 ft. below land surface measured on mo/day/yr  
 Pump test data: Well water was 20 ft. after 8 hours pumping 20 gpm  
 Est. Yield 20 gpm Well water was 8 ft. after 8 hours pumping 20 gpm  
 Bore Hole Diameter 8 in. to 8 in. and 8 in. to 8 in.  
 WELL WATER TO BE USED AS:  
 1 Domestic 1 3 Feedlot 1 6 Oil field water supply 1 9 Dewatering 1 12 Other (Specify below)  
 2 Irrigation 1 4 Industrial 1 7 Lawn and garden only 1 10 Observation well 1  
 Was a chemical/bacteriological sample submitted to Department? Yes No; If yes, mo/day/yr sample was submitted Water Well Disinfected? Yes No

5 TYPE OF BLANK CASING USED:  
 1 Steel 5 3 RMP (SR) 5 5 Wrought iron 5 8 Concrete tile 5 CASING JOINTS: Glued Clamped  
 2 PVC 5 4 ABS 5 6 Asbestos-Cement 5 9 Other (specify below) Welded  
 7 Fiberglass 5 Threaded 5  
 Blank casing diameter 5 in. to 0-28 ft., Dia 5 in. to 38-58 ft., Dia 5 in. to 63-70 ft.  
 Casing height above land surface 29 in., weight 282 lbs./ft. Wall thickness or gauge No. 258  
 TYPE OF SCREEN OR PERFORATION MATERIAL:  
 1 Steel 7 3 Stainless steel 7 5 Fiberglass 7 8 RMP (SR) 7 10 Asbestos-cement 7  
 2 Brass 7 4 Galvanized steel 7 6 Concrete tile 7 9 ABS 7 11 Other (specify) 7  
 12 None used (open hole) 7  
 SCREEN OR PERFORATION OPENINGS ARE:  
 1 Continuous slot 7 3 Mill slot 7 5 Gauzed wrapped 7 8 Saw cut 7 11 None (open hole) 7  
 2 Louvered shutter 7 4 Key punched 7 6 Wire wrapped 7 9 Drilled holes 7  
 7 Torch cut 7 10 Other (specify) 7  
 SCREEN-PERFORATED INTERVALS: From 28 ft. to 38 ft., From 58 ft. to 63 ft., From 10 ft. to 70 ft.  
 GRAVEL PACK INTERVALS: From 10 ft. to 70 ft., From 10 ft. to 70 ft., From 10 ft. to 70 ft.

6 GROUT MATERIAL: 1 Neat cement 1 2 Cement grout 1 3 Bentonite 1 4 Other 1  
 What is the nearest source of possible contamination:  
 1 Septic tank 1 4 Lateral lines 1 7 Pit privy 1 10 Livestock pens 1 14 Abandoned water well 1  
 2 Sewer lines 1 5 Cess pool 1 8 Sewage lagoon 1 11 Fuel storage 1 15 Oil well/Gas well 1  
 3 Watertight sewer lines 1 6 Seepage pit 1 9 Feedyard 1 12 Fertilizer storage 1 16 Other (specify below) 1  
 13 Insecticide storage 1  
 Direction from well? S How many feet? 260

FROM	TO	LITHOLOGIC LOG	FROM	TO	LITHOLOGIC LOG
0	2	Top soil			
2	50	Clay, brown			
5	18	Shale, yellow			
18	20	20LS tan			
20	30	19 Shale, red			
30	32	20LS, grey, loose 20gpm			
32	50	19 Shale red			
50	55	20LS, grey			
55	63	19 Shale, grey			
63	69	20LS, grey			
69	70	19 Shale, grey			

7 CONTRACTOR'S OR LANDOWNER'S CERTIFICATION: This water well was (1) constructed, (2) reconstructed, or (3) plugged under my jurisdiction and was completed on (mo/day/year) 7-16-84 and this record is true to the best of my knowledge and belief. Kansas Water Well Contractor's License No. 182 This Water Well Record was completed on (mo/day/yr) 7-20-84 under the business name of Strader Dr. Co., Inc. by (signature) Salvador

INSTRUCTIONS: Use typewriter or ball point pen, PLEASE PRESS FIRMLY and PRINT clearly. Please fill in blanks, underline or circle the correct answers. Send top three copies to Kansas Department of Health and Environment, Division of Environment, Environmental Geology Section, Topeka, KS 66620. Send one to WATER WELL OWNER and retain one for your records.